



Ref:

Date:

الرقم: ٣٨٦٨/١/٧ التاريخ: ٨/١٩/٢٠٢١

السادة المناقصين

الموضوع: العطاء رقم C-T-W-2021-0039
الخاص مشروع اعادة تأهيل محطة ضخ عين الديك

ارفق طيه الملحق رقم (3) للعطاء اعلاه ويعتبر هذا الملحق جزءاً لا يتجزأ من وثائق العطاء للتقيد به والعمل بمضمونه كالاتي :

س 1 : يرجى التكرم بتوضيح مدة التنفيذ لاجمال العطاء ، حيث ذكر في جدول ملحق رقم (2) ان مدة الانجاز هي (60) يوم وذكر في الوصف بان مدة التنفيذ (120) يوم ، يرجى تحديد مدة تنفيذ الاعمال الفعلية بدون فترة التشغيل ، مع العلم بان اغلب المعدات لمتل هذا المشروع تحتاج مدة توريد من السوق الاجنبي بفترة لا تقل عن (90) يوم .

ج-1 : لاعتماد مدة التنفيذ الوارده في النقطة رقم (1) من البند (حادي عشر : شروط اخرى) وليس ما جاء بالمادة (9/1/1) من (ج-2 الملحق) .

واقبلوا الاحترام

المهندس منتصر فاضل المومني
مدير عام شركة مياه اليرموك

نسخة الى :

- ✓ مدير مديرية العطاءات والمشتريات
- ✓ مدير مديرية الشؤون الفنية
- ✓ السيدة هبة معابره / الارشفة
- ✓ م ملك ابو زيتون/مديرية العطاءات والمشتريات

Yarmouk Water Company

Irbid, Baghdad St. P.O. Box 3798, Irbid 21110 Jordan

Tel: +962 2 727 5477 Fax: +962 2 727 0707

Website: www.yw.com.jo Email: info@yw.com.jo

شركة مياه اليرموك

اريد: شارع بغداد ص.ب: 378 اربد الاردن

هاتف: +96227275477 فاكس: +96227270707

الموقع الالكتروني: www.yw.com.jo البريد الالكتروني: info@yw.com.jo

لوحات التعريف

على المناقص توريد وتركيب ما يلي:

- لوحة تعريف وتشغيل مصنوعة من مادة غير قابلة للتلف بسهولة توضح تسلسل المعالجة والاجهزة المستخدمة وجميع اجهزة القياس والمحاسب والردادات... الخ ويتم تعليقها في مكان واضح في المحطة.
- لوحة تعريف بكل جهاز تم تركيبه في المحطة.
- اعطاء ارقام لجميع المحاسب وتسميتها وتلوين الخطوط لمعرفة خط مياه المنتج من الخام من الرفوض. ووضع أسهم لاتجاه لياه.

حادي عشر: متطلبات أخرى

- 1- المدة الكلية لتنفيذ جميع اعمال العطاء من ثلاثة الى اربعة اشهر من تاريخ أمر المباشرة وهي الفترة اللازمة لتوريد المعدات والاجهزة اللازمة للمحطة وتركيبها وتشغيلها وبشرط ان لا تزيد مدة تركيب المعدات والاجهزة الموردة وتشغيلها عن ٢١ يوم
- 2- على المقاول المحافظة على استمرار عمليات التشغيل في المحطة وبالتنسيق الكامل مع إدارة مياه محافظة جرش وعمل ما يلزم لضمان ذلك.
- 3- ان يكون المناقص قد عمل سابقا في مجال توريد وتشغيل محطات معالجة بالأغشية بطاقة مياه منتجة لا تقل عن انتاجية الوحدة اعلاه
- 4- على المناقص أن يتحمل مسؤولية جميع الأعمال الهندسية والتصميم والتنفيذ والتشغيل ونجاح فحوصات المياه حسب المواصفة الأردنية لمياه الشرب رقم ٢٠١٥/٢٨٦
- 5- تكون جميع الكلف الخاصة بتشغيل وحدات المعالجة في الفترة ما قبل الاستلام مشمولة بأسعار هذا العطاء.
- 6- ان يقوم المناقص الحال عليه العطاء (المقاول) بأخذ موافقة شركة مياه اليرموك السابقة على المواد قبل شرائها وتوريدها وتقديم تفاصيل التصميم لجميع وحدات المعالجة والخططات الكهربائية والميكانيكية وال Lay out قبل القيام بالعمل للموافقة عليها.
- 7- تقديم قائمة قطع غيار لجميع اجزاء المحطة تكفيها لمدة سنتين مع بيان اسعارها الافراذية وان يلتزم المناقص بتوريدها خلال السنتين في حال طلبها من قبل شركة مياه اليرموك وهي ملزمة للمنافس وغير ملزمة لشركة مياه اليرموك.
- 8- على المناقص ارفاق جميع الكتالوجات والنشرات الفنية لأي جهاز أو مضخة يرغب بتوريدها في عرضه الفني
- 8- على المناقص الإشراف على مشغلي صاحب العمل العاملين على تشغيل محطة المعالجة لمدة سنة مع صيانة مجانية لكامل أجزائها تبدأ من تاريخ انتهاء فترة التشغيل التجريبي بحيث تشمل ما يلي:
 - a. استبدال أي قطعة غيار لأي جهاز تم تركيبه في المحطة.
 - b. حفظ الأغشية وغسلها مع المواد الكيماوية اللازمة للحفظ والغسيل كلما اقتضت الحاجة للأغشية أو الانواع القائمة والتي سيتم توريدها من خلال هذا العطاء.
 - c. الإشراف والمتابعة على التشغيل والاطلاع على الظروف التشغيلية للمحطة ومخاطبة الجهة المشرفة بأي خلل يحدث بالإضافة إلى ارسال تقرير شهري يتضمن كافة الظروف التشغيلية للمحطة وإعمال الصيانة التي اجريت في حال حدوثها.
 - d. زيارة المحطة بشكل دوري وعمل الصيانات الدورية لأجهزتها ومضخاتها
 - e. قيام المقاول بجميع أعمال الصيانة والطوارئ المطلوبة في المحطة بحيث يكون المقاول تحت الطلب (وخلال ٢٤ ساعة من ابلاغه)
- 9- على المناقص أن يؤكد بأن جميع الاجهزة المعروضة خالية من أي مشاكل في التصميم والتصنيع وانها مناسبة من حيث الحجم والقدرة لظروف التشغيل بالإضافة إلى انها مصنوعة من مادة مناسبة لنوعية لياه المراد معالجتها.
- 10- في حال حدوث خلل في تصميم وتصنيع الاجهزة أو مواصفات التشغيل التي قد تظهر خلال عام من تاريخ الإستلام الأولي ويتحمل المناقص المسؤولية الكاملة في ازالة هذا الخلل أو استبدال الاجزاء المعطلة دون أي تكاليف تتحملها شركة مياه اليرموك وعلى المناقص ان يتحمل تكاليف نقل من وإلى موقع العمل.
- 11- في حال عدم تمكن المناقص من اصلاح الخلل يتوجب عليه استبدال الاجهزة السببة للخلل بأجهزة جديدة وعلى حسابه الخاص ودون تأخير وبخلافه ستقوم شركة مياه اليرموك بالشراء على حسابه وتحميله الفرق.
- 12- المواصفات الفنية المذكورة اعلاه هي مواصفات أداء وعلى المناقص الذي سيحال عليه العطاء تقديم مواصفات تفصيلية كاملة لكل جزء من اجزاء المحطة لتحقيق الهدف اعلاه.
- 13- أي بند أو مطلب لم يتم ذكره في جدول الكميات الخاص بهذا العمل تكون كلفته محمله على اسعار البنود المذكورة جدول كميات العطاء.
- 14- تقديم المخططات والمانيولات ولوحات التعريف وتسلم عند الاستلام الأولي للمحطة بعد الانتهاء من تنفيذ المحطة

ج - ٢ الملحق Appendix

■ يعتبر هذا الملحق جزءاً من اتفاقية العقد .

ملاحظة: باستثناء البنود التي تمت تعبئتها وفقاً لمتطلبات صاحب العمل ، فإنّ المقاول ملزم باستكمال البيانات التالية قبل تقديم عرضه .

المادة	الموضوع	البيان
٢/١/١	المواصفات	المواصفات الفنية العامة والخاصة المتعلقة ١. الأبنية ٢. الطرق ٣. المياه والمجاري
٣/١/١	المخططات	
	كفالة الدخول في المناقصة	
٩/١/١	مدة الإنجاز	(٦٠ يوم) تقويمياً
٣/١	أولوية وثائق العقد	١- الاتفاقية ٢- الشروط الخاصة ٣- الشروط العامة ٤- المواصفات ٥- المخططات ٦- تصميم المقاول (إن وجد) ٧- جداول الكميات
٤/١	القانون الذي يحكم العقد	القانون الأردني
٥/١	لغة العقد	اللغة العربية
١/٢	توفير الموقع	بتاريخ المباشرة
١/٣	ممثل صاحب العمل	
٢/٣	المهندس	
٤/٤	ضمان الأداء (كفالة حسن التنفيذ) - القيمة	(١٠ %) من قيمة العقد
	كفالة إصلاح العيوب (كفالة الصيانة)	(٥ %) قيمة الأشغال المنجزة
١/٥	متطلبات تصميم المقاول (إن وجد التصميم)	
٢/٧	برنامج العمل - على المقاول تقديمه- النموذج	خلال (٧) أيام من تاريخ المباشرة برنامج خطي
٤/٧	تعويضات التأخير - القيمة	(٢٥٠) دينار عن كل يوم تأخير



Ref:

Date:

التاريخ: ٢٧/١٠/٢٠٢١

الرقم: ٣٧٥٩ / ١١٧

السادة المناقصين

الموضوع: العطاء رقم C-T-W-2021-0039
الخاص مشروع اعادة تأهيل محطة ضخ عين الديك

ارفق طيه الملحق رقم (2) للعطاء اعلاه ويعتبر هذا الملحق جزء لا يتجزأ من وثائق العطاء للتقيد به والعمل بمضمونه كالاتي :

- س 1 : ارجو منكم تزويدنا بتحليل للمياه الخام خلال السنوات الماضية المتوفرة وبمخطط عام للموقع يظهر فيه المساحات المتوفرة .
- ج 1 : مرفق طية نتائج تحليل المياه الخام خلال السنوات الماضية المتوفرة.
- س 2 : ماهي اقل درجة حراره واعلى درجة للمياه الخام
- ج 2 : درجات حرارة المياه الخام حاليا 28.5 درجة ولا توجد لدينا معلومات وبيانات حول مقدارها خلال فترات الشتاء .

واقبلوا الاحترام

المهندس منتصر فاضل المومني
مدير عام شركة مياه اليرموك

نسخة ال :

- ✓ مدير مديرية العطاءات والشريات
- ✓ مدير مديرية الشؤون الفنية
- ✓ السيده هبه معابره / الارشفة
- ✓ م ملاك ابو زيتون/مديرية العطاءات والشريات

Yarmouk Water Company

Irbid, Baghdad St. P.O. Box 3798, Irbid 21110 Jordan

Tel: +962 2 727 5477 Fax: +962 2 727 0707

Website: www.yw.com.jo Email: info@yw.com.jo

شركة مياه اليرموك

اريد: شارع بغداد ص.ب: 378 اربد الاردن

هاتف: +96227275477 فاكس: +96227270707

الموقع الالكتروني: www.yw.com.jo البريد الالكتروني: info@yw.com.jo

AS BUILT




























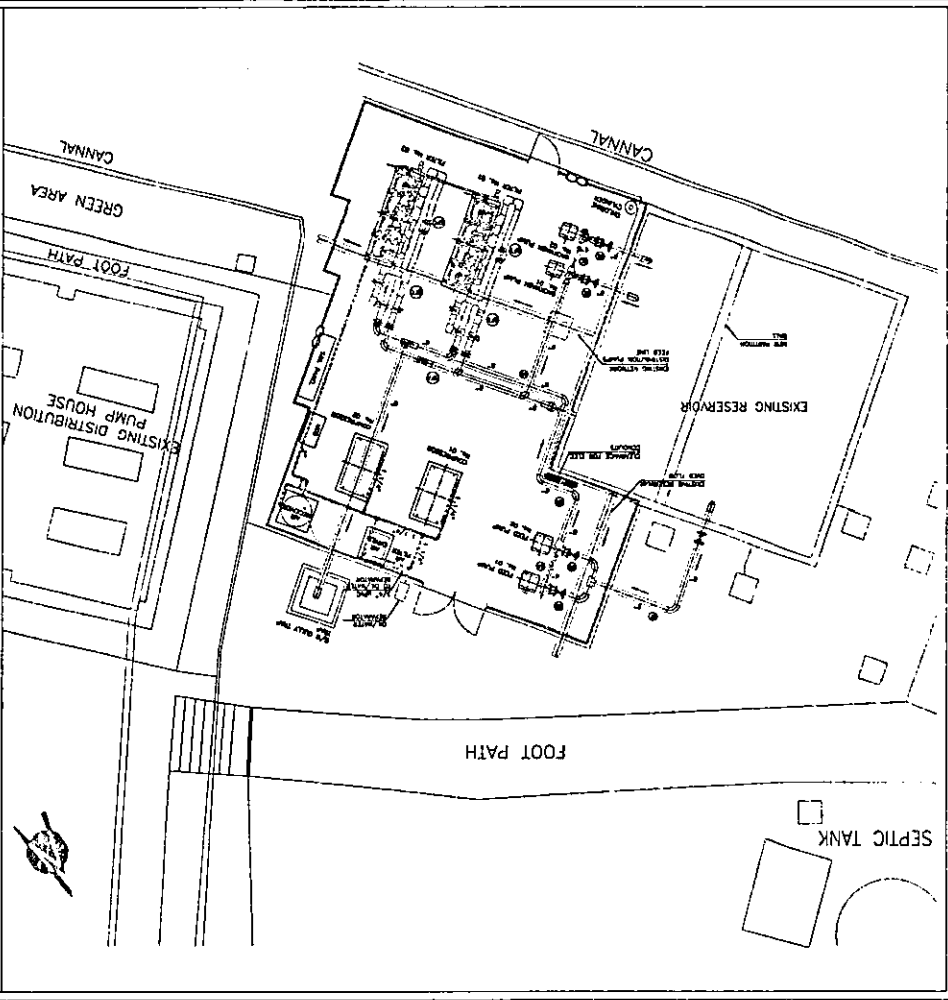

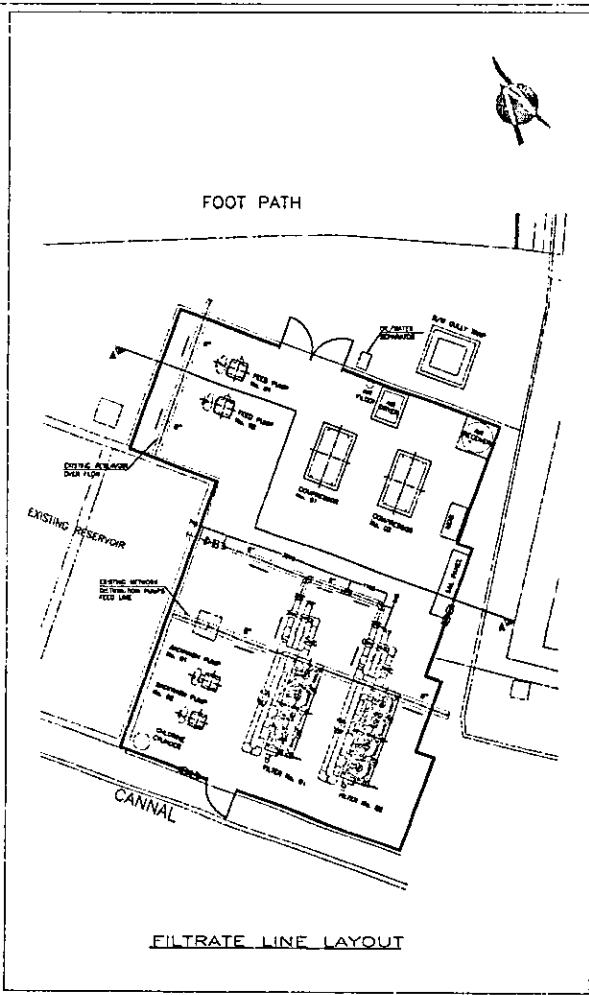

FILTRATE LINE LAYOUT

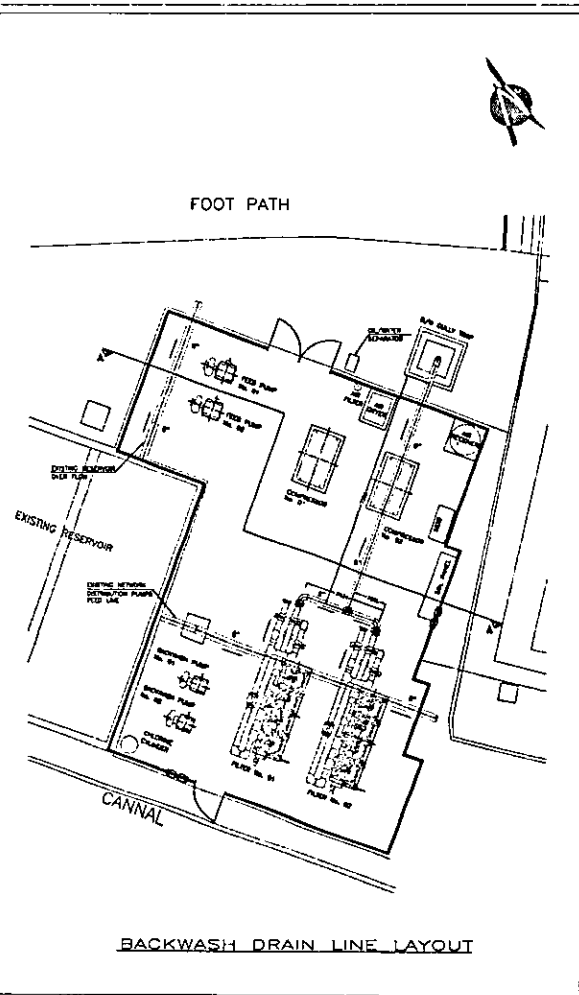

BACKWASH DRAIN LINE LAYOUT

NOTES:-

1. THIS DRAWING SHOWS AS BUILT FILTER PLANT EQUIPMENT AND INSTALLATIONS.
2. ALL DIMENSIONS ARE IN MILLIMETER AND ELEVATIONS ARE IN METERS, UNLESS OTHERWISE INDICATED.
3. FOR INDIVIDUAL PIPE LINE DETAILS SEE DRAWINGS No. 1 - FEED LINE: DK-M-S-401 R1
2 - BACKWASH LINE: DK-M-S-401 R1
4. FOR SUPPORTS & SEALS DETAILS, REFER TO DRAWING No. 1 - DK-M-S-403 R1
5. FOR COMPRESSED AIR PIPING AND PNEU DRAWING, REFER TO DRAWING No. 1 - DK-M-S-407 R1
6. FOR FILTERS GENERAL ARRANGEMENT SEE S&C DRAWING No. 1 - FILTERS ACCORD: 800 - 1008 - 11 Rev. B
- LIFTING STATION: 800 - 1028 - 8
7. FOR ELECTRICAL AS BUILT LAYOUTS & DETAILS, REFER TO DRAWINGS No. 1 - POWER CABLE LAYOUT & DETAILS: DK-C-S-400 R2
- CONTROL CABLE LAYOUT & DETAILS: DK-C-S-401 R2
8. ALL COMPRESSED AIR PIPES ARE GALVANIZED CARBON STEEL, SCH. 40.
9. ALL COMPRESSED AIR PIPE FITTINGS ARE STANDARD BRIGG'S GALVANIZED WALLEABLE IRON.
10. ALL PIPES ARE CARBON STEEL, SCHEDULE 40, UNLESS OTHER WISE INDICATES.
11. ALL PIPE AND FITTING SURFACES ARE FINISHED WITH SPOUT PAINT TO THE COLOR CODE.

LEGEND:-

	BALL VALVE		FLEXIBLE CONNECTOR, DOUBLE FLANGED
	GATE VALVE		AIR RELEASE VALVE, WITH ISOLATING VALVE
	CHECK VALVE		BUTTERFLY VALVE
	MOTORIZED VALVE (PNEUMATIC)		SUPPORT TYPE A
			MAGNETIC FLOW METER

AS BUILT

NO.	DESCRIPTION	DATE	BY	CHECKED
1	ISSUED FOR CONSTRUCTION	11/11/2011	AL	AL
2	AS BUILT	11/11/2011	AL	AL

THE HASHEMITE KINGDOM OF JORDAN
WATER AUTHORITY OF JORDAN AMMAN

THE REHABILITATION OF PRIORITY SPRINGS & WELLS
JORDAN

CLIENT: USAID - AMMAN JORDAN
CONTRACT NO.: 178-C-00-88-00031-00

CONSULTANT: ENVIRONMENTAL HEALTH PROJECT
CDM Camp Dresser & McKee International Inc.
ASSOCIATED CONSULTING ENGINEERS
ACE AMMAN

CONTRACTOR: **MORGANTI GROUP INC.** AMMAN


AL GLEEK
GENERAL EQUIPMENT LAYOUT
FILTRATE AND BACKWASH DRAIN LINES PIPE ROUTING

1:30 DK-M-S-402 1

FEED PUMPS SPECS.

CORNELL PUMP Co.	
PUMP MODEL	288 - 40 - 1
SERIAL No.	
PUMP No. 01	108187 12.25
PUMP No. 02	108188 12.25
CAPACITY (m ³ /H)	150
HEAD (m)	28.28
POWER (KW)	30
QUANTITY	1 (OPERATING)
	1 (STAND BY)

FOOT PATH

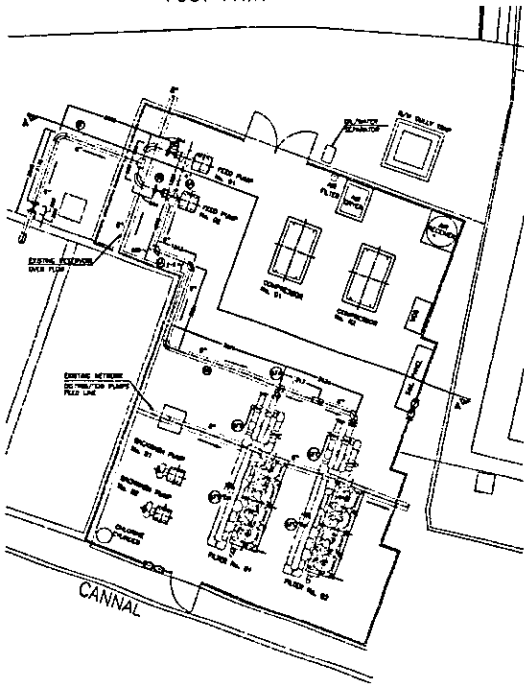


FEED LINE LAYOUT

BACKWASH PUMPS SPECS.

CORNELL PUMP Co.	
PUMP MODEL	288 - 13 - 7
SERIAL No.	
PUMP No. 01	108770 8.38
PUMP No. 02	108757 8.42
CAPACITY (m ³ /H)	80
HEAD (m)	27.72
POWER (KW)	11
QUANTITY	1 (OPERATING)
	1 (STAND BY)

FOOT PATH

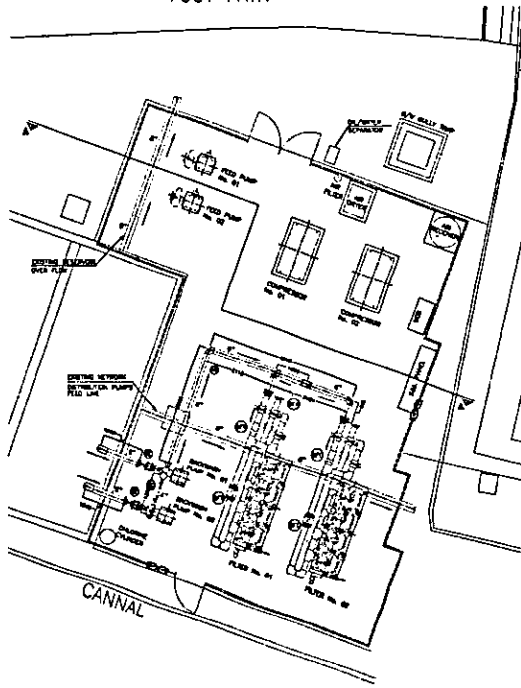

BACKWASH LINE LAYOUT

NOTES:-

- THIS DRAWING SHOWS AS BUILT FILTER PLANT COMPONENT AND INSTALLATIONS.
- ALL DIMENSIONS ARE IN MILLIMETER AND ELEVATIONS ARE IN METERS, UNLESS OTHERWISE INDICATED.
- FOR INDIVIDUAL PIPE LINE DETAILS, SEE DRAWINGS No.:
- FILTER LINE: DK-M-S-402 R1
- BACKWASH DRINK LINE: DK-M-S-402 R1
- FOR SUPPORTS & SEALS DETAILS, REFER TO DRAWING No.:
- LIFTING STANDARDS: DK-M-S-403 R1
- FOR COMPRESSED AIR PIPING AND PANO DRAWING, REFER TO DRAWING No.: DK-M-S-407 R0
- FOR FILTERS GENERAL ARRANGEMENT SEE S&I DRAWING No.:
- FILTERED AIR: 880 - 1008 - 11 Rev. 0
- LIFTING STANDARDS: 880 - 1008 - 08
- FOR ELECTRICAL AS BUILT LAYOUTS & DETAILS, REFER TO DRAWINGS No.:
- POWER CABLE LAYOUT & DETAILS: DK-E-S-203 R2
- CONTROL CABLE LAYOUT & DETAILS: DK-E-S-401 R2
- ALL COMPRESSED AIR PIPES ARE GALVANIZED CARBON STEEL, SCH 40.
- ALL COMPRESSED AIR PIPE FITTINGS ARE STANDARD WEIGHT GALVANIZED MALLEABLE IRON.
- ALL PIPES ARE CARBON STEEL, SCH 40, UNLESS OTHERWISE INDICATED.
- ALL PIPE AND FITTING SURFACES ARE FINISHED WITH EPOXY PAINT TO THE COLOR CODE.

LEGEND:-

- | | | | |
|--|-----------------------------|--|--|
| | BALL VALVE | | FLEXIBLE CONNECTION, DOUBLE FLANGED. |
| | GATE VALVE | | AIR RELEASE VALVE, WITH SOULATING VALVE. |
| | CHECK VALVE | | BUTTERFLY VALVE. |
| | MOTORIZED VALVE (PNEUMATIC) | | SUPPORT TYPE A |
| | | | MAGNETIC FLOW METER |

AS BUILT


THE HASHEMITE KINGDOM OF JORDAN
WATER AUTHORITY OF JORDAN AMMAN
THE REHABILITATION OF PRIORITY SPRINGS & WELLS
JORDAN

CLIENT: USAID - AMMAN JORDAN
CONTRACT No.: 278-C-00-00-00031-00

CONSULTING: **EH&P** ENVIRONMENTAL HEALTH PROJECT
CDM Camp Dresser & McKee International Inc.
& associated with **ACEB** ASSOCIATED CONSULTING ENGINEERS AMMAN

CONTRACTOR: **MORGANTI GROUP INC.** AMMAN

SCALE: AL DEER GENERAL EQUIPMENT LAYOUT / FEED IN AND BACKWASH LINES PIPE ROUTING
1:50 DK-M-S-401 1

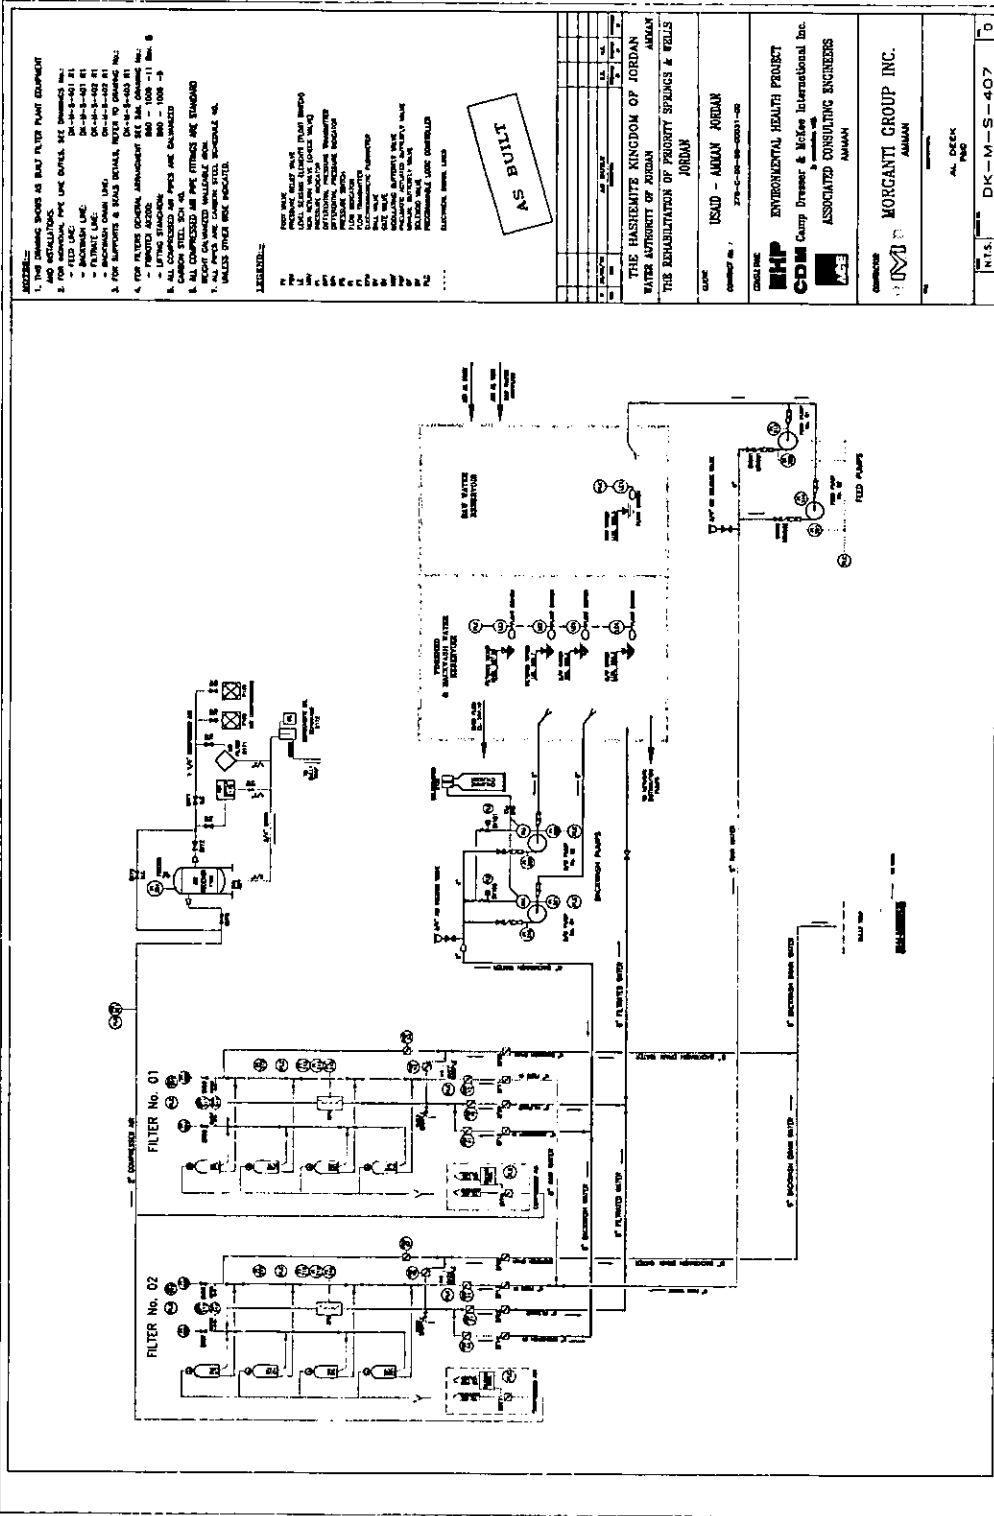

 7. EXCEPT AS NOTED, ALL PIPING SHALL BE INSTALLED IN ACCORDANCE WITH THE FOLLOWING:
 - MACHINERY CODE
 - PLUMBING CODE
 - AIR CONDITIONING INSTITUTE (ACI)
 - NATIONAL FIRE PROTECTION ASSOCIATION (NFPA)
 - AMERICAN SOCIETY OF MECHANICAL ENGINEERS (ASME)
 8. ALL COMPRESSED AIR PIPES ARE GALVANIZED.

AS BUILT

NO.	DESCRIPTION	DATE	BY	CHKD.

THE HASHEMITE KINGDOM OF JORDAN
 WATER AUTHORITY OF JORDAN AMMAN
 THE REHABILITATION OF PRIORITY SPRINGS & WELLS
 JORDAN

OWNER: USAID - AMMAN JORDAN
 CONTRACT No. J278-02-00-00-00001-00

CLIENT: ENVIRONMENTAL HEALTH PROTECT
CDM Corp. Dresser & McKee International Inc.
 ASSOCIATED CONSULTING ENGINEERS
 AMMAN

 AMMAN

AL DEEK
 PMD
 R.T.S. DK-M-S-407 0

156517	WJ021890	23-JAN-2018 09:40:00.00	Ain Deek & Teis Drinking Water Treatment Plant	POST_FILTER	0.83	<1.0	<1.0
156696	WJ021915	25-JAN-2018 10:00:00.00	Ain Deek & Teis Drinking Water Treatment Plant	RW	1.01	93.4	1119.9
156697	WJ021915	25-JAN-2018 10:05:00.00	Ain Deek & Teis Drinking Water Treatment Plant	POST_UV	0.93	<1.0	<1.0
156698	WJ021915	25-JAN-2018 10:10:00.00	Ain Deek & Teis Drinking Water Treatment Plant	POST_FILTER	0.77	<1.0	<1.0
156699	WJ021915	25-JAN-2018 10:15:00.00	Ain Deek & Teis Drinking Water Treatment Plant	FINALPROD	0.67	Absence	Absence
156761	WJ021922	28-JAN-2018 09:00:00.00	Ain Deek & Teis Drinking Water Treatment Plant	RW	1.19	54.6	1732.9
156762	WJ021922	28-JAN-2018 09:10:00.00	Ain Deek & Teis Drinking Water Treatment Plant	POST_UV	0.91	<1.0	<1.0
156763	WJ021922	28-JAN-2018 09:15:00.00	Ain Deek & Teis Drinking Water Treatment Plant	POST_FILTER	0.8	2	9.8
156764	WJ021922	28-JAN-2018 09:20:00.00	Ain Deek & Teis Drinking Water Treatment Plant	FINALPROD	0.79	Absence	Absence
156941	WJ021945	30-JAN-2018 10:15:00.00	Ain Deek & Teis Drinking Water Treatment Plant	RW	1.09	11	127.4
156942	WJ021945	30-JAN-2018 10:20:00.00	Ain Deek & Teis Drinking Water Treatment Plant	POST_UV	0.92	<1.0	<1.0
156943	WJ021945	30-JAN-2018 10:25:00.00	Ain Deek & Teis Drinking Water Treatment Plant	POST_FILTER	0.85	<1.0	<1.0
156944	WJ021945	30-JAN-2018 10:30:00.00	Ain Deek & Teis Drinking Water Treatment Plant	FINALPROD	0.77	Absence	Absence
157048	WJ021963	1-FEB-2018 08:30:00.00	Ain Deek & Teis Drinking Water Treatment Plant	RW	0.87	10.4	101
157049	WJ021963	1-FEB-2018 08:35:00.00	Ain Deek & Teis Drinking Water Treatment Plant	POST_UV	0.72	<1.0	<1.0
157050	WJ021963	1-FEB-2018 08:40:00.00	Ain Deek & Teis Drinking Water Treatment Plant	POST_FILTER	0.62	<1.0	1
157051	WJ021963	1-FEB-2018 08:45:00.00	Ain Deek & Teis Drinking Water Treatment Plant	FINALPROD	0.55	Absence	Absence
157137	WJ021971	4-FEB-2018 10:00:00.00	Ain Deek & Teis Drinking Water Treatment Plant	RW	1.08	13.4	113.7
157138	WJ021971	4-FEB-2018 10:05:00.00	Ain Deek & Teis Drinking Water Treatment Plant	POST_UV	0.91	<1.0	<1.0
157139	WJ021971	4-FEB-2018 10:10:00.00	Ain Deek & Teis Drinking Water Treatment Plant	POST_FILTER	0.83	<1.0	<1.0
157140	WJ021971	4-FEB-2018 10:25:00.00	Ain Deek & Teis Drinking Water Treatment Plant	FINALPROD	0.62	Absence	Absence
157263	WJ021990	6-FEB-2018 09:00:00.00	Ain Deek & Teis Drinking Water Treatment Plant	RW	0.97	13.5	76.7
157264	WJ021990	6-FEB-2018 09:05:00.00	Ain Deek & Teis Drinking Water Treatment Plant	POST_UV	0.9	<1.0	<1.0
157265	WJ021990	6-FEB-2018 09:10:00.00	Ain Deek & Teis Drinking Water Treatment Plant	POST_FILTER	0.81	<1.0	1
157266	WJ021990	6-FEB-2018 09:15:00.00	Ain Deek & Teis Drinking Water Treatment Plant	FINALPROD	0.67	Absence	Absence
157488	WJ022022	8-FEB-2018 09:00:00.00	Ain Deek & Teis Drinking Water Treatment Plant	RW	0.99	26.5	90.8
157489	WJ022022	8-FEB-2018 09:05:00.00	Ain Deek & Teis Drinking Water Treatment Plant	POST_UV	0.85	<1.0	<1.0
157490	WJ022022	8-FEB-2018 09:10:00.00	Ain Deek & Teis Drinking Water Treatment Plant	POST_FILTER	0.76	<1.0	<1.0
157491	WJ022022	8-FEB-2018 09:15:00.00	Ain Deek & Teis Drinking Water Treatment Plant	FINALPROD	0.65	Absence	Absence
157552	WJ022034	11-FEB-2018 08:35:00.00	Ain Deek & Teis Drinking Water Treatment Plant	RW	0.95	18.5	61.3
157553	WJ022034	11-FEB-2018 08:40:00.00	Ain Deek & Teis Drinking Water Treatment Plant	POST_UV	0.8	<1.0	<1.0
157554	WJ022034	11-FEB-2018 08:45:00.00	Ain Deek & Teis Drinking Water Treatment Plant	POST_FILTER	0.61	<1.0	1
157555	WJ022034	11-FEB-2018 08:50:00.00	Ain Deek & Teis Drinking Water Treatment Plant	FINALPROD	0.69	Absence	Absence
157750	WJ022063	13-FEB-2018 09:00:00.00	Ain Deek & Teis Drinking Water Treatment Plant	RW	1.12	40.4	770.1
157751	WJ022063	13-FEB-2018 09:05:00.00	Ain Deek & Teis Drinking Water Treatment Plant	POST_UV	0.97	<1.0	<1.0
157752	WJ022063	13-FEB-2018 09:10:00.00	Ain Deek & Teis Drinking Water Treatment Plant	POST_FILTER	0.85	<1.0	1
157753	WJ022063	13-FEB-2018 09:15:00.00	Ain Deek & Teis Drinking Water Treatment Plant	FINALPROD	1.5	Absence	Absence
157882	WJ022086	15-FEB-2018 10:00:00.00	Ain Deek & Teis Drinking Water Treatment Plant	RW	1.09	160.7	1413.6
157883	WJ022086	15-FEB-2018 10:05:00.00	Ain Deek & Teis Drinking Water Treatment Plant	POST_UV	0.91	<1.0	<1.0
157884	WJ022086	15-FEB-2018 10:10:00.00	Ain Deek & Teis Drinking Water Treatment Plant	FINALPROD	0.82	Absence	Absence
157885	WJ022086	15-FEB-2018 10:15:00.00	Ain Deek & Teis Drinking Water Treatment Plant	POST_FILTER	0.9	<1.0	<1.0
157970	WJ022097	18-FEB-2018 09:30:00.00	Ain Deek & Teis Drinking Water Treatment Plant	RW	2.73	770.1	>2419.6
157971	WJ022097	18-FEB-2018 09:35:00.00	Ain Deek & Teis Drinking Water Treatment Plant	POST_UV	1.72	<1.0	<1.0
157972	WJ022097	18-FEB-2018 09:40:00.00	Ain Deek & Teis Drinking Water Treatment Plant	POST_FILTER	1.12	<1.0	1
157973	WJ022097	18-FEB-2018 09:45:00.00	Ain Deek & Teis Drinking Water Treatment Plant	FINALPROD	0.99	Absence	Absence
158195	WJ022128	20-FEB-2018 09:20:00.00	Ain Deek & Teis Drinking Water Treatment Plant	RW	1.93	56.1	1119.9
158196	WJ022128	20-FEB-2018 09:25:00.00	Ain Deek & Teis Drinking Water Treatment Plant	POST_UV	1.71	<1.0	<1.0
158197	WJ022128	20-FEB-2018 09:30:00.00	Ain Deek & Teis Drinking Water Treatment Plant	POST_FILTER	1.6	<1.0	<1.0
158198	WJ022128	20-FEB-2018 09:35:00.00	Ain Deek & Teis Drinking Water Treatment Plant	FINALPROD	1.02	Absence	Absence
158284	WJ022142	22-FEB-2018 10:00:00.00	Ain Deek & Teis Drinking Water Treatment Plant	RW	1.2	53.7	410.6
158285	WJ022142	22-FEB-2018 10:05:00.00	Ain Deek & Teis Drinking Water Treatment Plant	POST_UV	0.98	<1.0	<1.0
158286	WJ022142	22-FEB-2018 10:10:00.00	Ain Deek & Teis Drinking Water Treatment Plant	POST_FILTER	0.81	<1.0	1
158287	WJ022142	22-FEB-2018 10:15:00.00	Ain Deek & Teis Drinking Water Treatment Plant	FINALPROD	0.72	Absence	Absence
158348	WJ022154	25-FEB-2018 10:10:00.00	Ain Deek & Teis Drinking Water Treatment Plant	RW	1.21	88.4	727
158349	WJ022154	25-FEB-2018 10:15:00.00	Ain Deek & Teis Drinking Water Treatment Plant	POST_UV	0.93	<1.0	<1.0
158350	WJ022154	25-FEB-2018 09:46:00.00	Ain Deek & Teis Drinking Water Treatment Plant	POST_FILTER	0.8	<1.0	<1.0
158351	WJ022154	25-FEB-2018 10:25:00.00	Ain Deek & Teis Drinking Water Treatment Plant	FINALPROD	0.69	Absence	Absence
158531	WJ022172	28-FEB-2018 08:00:00.00	Ain Deek & Teis Drinking Water Treatment Plant	RW	1.17	26.2	290.9
158532	WJ022172	28-FEB-2018 08:05:00.00	Ain Deek & Teis Drinking Water Treatment Plant	POST_UV	0.93	<1.0	<1.0
158533	WJ022172	27-FEB-2018 08:10:00.00	Ain Deek & Teis Drinking Water Treatment Plant	POST_FILTER	0.8	<1.0	<1.0
158534	WJ022172	27-FEB-2018 08:15:00.00	Ain Deek & Teis Drinking Water Treatment Plant	FINALPROD	0.71	Absence	Absence
158665	WJ022191	1-MAR-2018 09:00:00.00	Ain Deek & Teis Drinking Water Treatment Plant	RW	1.22	68.4	816.4
158666	WJ022191	1-MAR-2018 09:05:00.00	Ain Deek & Teis Drinking Water Treatment Plant	POST_UV	0.95	<1.0	<1.0
158667	WJ022191	1-MAR-2018 09:10:00.00	Ain Deek & Teis Drinking Water Treatment Plant	POST_FILTER	0.8	<1.0	<1.0
158668	WJ022191	1-MAR-2018 09:15:00.00	Ain Deek & Teis Drinking Water Treatment Plant	FINALPROD	0.71	Absence	Absence
158739	WJ022200	4-MAR-2018 09:00:00.00	Ain Deek & Teis Drinking Water Treatment Plant	RW	1.11	7.5	69.7
158740	WJ022200	4-MAR-2018 09:05:00.00	Ain Deek & Teis Drinking Water Treatment Plant	POST_UV	0.9	<1.0	<1.0
158741	WJ022200	4-MAR-2018 09:10:00.00	Ain Deek & Teis Drinking Water Treatment Plant	POST_FILTER	0.8	<1.0	<1.0

158742	WJ022200	4-MAR-2018 09:15:00.00	Ain Deek & Teis Drinking Water Treatment Plant	FINALPROD	0.77	Absence	Absence
159161	WJ022261	8-MAR-2018 09:10:00.00	Ain Deek & Teis Drinking Water Treatment Plant	RW	1.03	10.9	79.4
159162	WJ022261	8-MAR-2018 09:15:00.00	Ain Deek & Teis Drinking Water Treatment Plant	POST_UV	0.89	<1.0	<1.0
159163	WJ022261	8-MAR-2018 09:20:00.00	Ain Deek & Teis Drinking Water Treatment Plant	POST_FILTER	0.8	<1.0	<1.0
159164	WJ022261	8-MAR-2018 09:25:00.00	Ain Deek & Teis Drinking Water Treatment Plant	FINALPROD	0.69	Absence	Absence
159181	WJ022267	11-MAR-2018 08:50:00.00	Ain Deek & Teis Drinking Water Treatment Plant	RW	1.09	11	65
159182	WJ022267	11-MAR-2018 08:55:00.00	Ain Deek & Teis Drinking Water Treatment Plant	POST_UV	0.91	<1.0	<1.0
159183	WJ022267	11-MAR-2018 09:00:00.00	Ain Deek & Teis Drinking Water Treatment Plant	POST_FILTER	0.82	<1.0	<1.0
159184	WJ022267	11-MAR-2018 09:10:00.00	Ain Deek & Teis Drinking Water Treatment Plant	FINALPROD	0.77	Absence	Absence
159350	WJ022289	13-MAR-2018 09:20:00.00	Ain Deek & Teis Drinking Water Treatment Plant	RW	0.91	5.2	60.2
159351	WJ022289	13-MAR-2018 09:25:00.00	Ain Deek & Teis Drinking Water Treatment Plant	POST_UV	0.87	<1.0	<1.0
159352	WJ022289	13-MAR-2018 09:30:00.00	Ain Deek & Teis Drinking Water Treatment Plant	POST_FILTER	0.63	<1.0	1
159353	WJ022289	13-MAR-2018 09:35:00.00	Ain Deek & Teis Drinking Water Treatment Plant	FINALPROD	0.57	Absence	Absence
159519	WJ022317	15-MAR-2018 09:00:00.00	Ain Deek & Teis Drinking Water Treatment Plant	RW	1.03	4	49.6
159520	WJ022317	15-MAR-2018 09:05:00.00	Ain Deek & Teis Drinking Water Treatment Plant	POST_UV	0.91	<1.0	<1.0
159521	WJ022317	15-MAR-2018 09:10:00.00	Ain Deek & Teis Drinking Water Treatment Plant	POST_FILTER	0.75	<1.0	<1.0
159522	WJ022317	15-MAR-2018 09:15:00.00	Ain Deek & Teis Drinking Water Treatment Plant	FINALPROD	0.7	Absence	Absence
159602	WJ022326	18-MAR-2018 08:25:00.00	Ain Deek & Teis Drinking Water Treatment Plant	RW	1.02	5.2	41.4
159648	WJ022326	18-MAR-2018 08:30:00.00	Ain Deek & Teis Drinking Water Treatment Plant	POST_UV	0.91	<1.0	<1.0
159649	WJ022326	18-MAR-2018 08:35:00.00	Ain Deek & Teis Drinking Water Treatment Plant	POST_FILTER	0.83	<1.0	<1.0
159650	WJ022326	18-MAR-2018 08:40:00.00	Ain Deek & Teis Drinking Water Treatment Plant	FINALPROD	0.79	Absence	Absence
159722	WJ022348	20-MAR-2018 08:20:00.00	Ain Deek & Teis Drinking Water Treatment Plant	RW	0.92	9.7	59.1
159723	WJ022348	20-MAR-2018 08:25:00.00	Ain Deek & Teis Drinking Water Treatment Plant	POST_UV	0.8	<1.0	<1.0
159724	WJ022348	20-MAR-2018 08:30:00.00	Ain Deek & Teis Drinking Water Treatment Plant	POST_FILTER	0.72	<1.0	<1.0
159725	WJ022348	20-MAR-2018 08:35:00.00	Ain Deek & Teis Drinking Water Treatment Plant	FINALPROD	0.65	Absence	Absence
159733	WJ022348	20-MAR-2018 08:40:00.00	Ain Deek & Teis Drinking Water Treatment Plant	RW	0.92		
159734	WJ022348	20-MAR-2018 08:45:00.00	Ain Deek & Teis Drinking Water Treatment Plant	FINALPROD	0.65		
159902	WJ022376	22-MAR-2018 09:00:00.00	Ain Deek & Teis Drinking Water Treatment Plant	RW	0.97	2	38.9
159903	WJ022376	22-MAR-2018 09:05:00.00	Ain Deek & Teis Drinking Water Treatment Plant	POST_UV	0.85	<1.0	<1.0
159904	WJ022376	22-MAR-2018 09:10:00.00	Ain Deek & Teis Drinking Water Treatment Plant	POST_FILTER	0.7	<1.0	<1.0
159905	WJ022376	22-MAR-2018 09:20:00.00	Ain Deek & Teis Drinking Water Treatment Plant	FINALPROD	0.64	Absence	Absence
159922	WJ022387	25-MAR-2018 09:30:00.00	Ain Deek & Teis Drinking Water Treatment Plant	RW	0.93	11	51.2
159993	WJ022387	25-MAR-2018 09:35:00.00	Ain Deek & Teis Drinking Water Treatment Plant	POST_UV	0.81	<1.0	<1.0
159994	WJ022387	25-MAR-2018 09:40:00.00	Ain Deek & Teis Drinking Water Treatment Plant	POST_FILTER	0.72	<1.0	<1.0
159995	WJ022387	25-MAR-2018 09:45:00.00	Ain Deek & Teis Drinking Water Treatment Plant	FINALPROD	0.65	Absence	Absence
160120	WJ022408	27-MAR-2018 09:00:00.00	Ain Deek & Teis Drinking Water Treatment Plant	RW	0.92	48	135.4
160121	WJ022408	27-MAR-2018 09:05:00.00	Ain Deek & Teis Drinking Water Treatment Plant	POST_UV	0.8	<1.0	<1.0
160122	WJ022408	27-MAR-2018 09:10:00.00	Ain Deek & Teis Drinking Water Treatment Plant	POST_FILTER	0.71	<1.0	<1.0
160123	WJ022408	27-MAR-2018 09:15:00.00	Ain Deek & Teis Drinking Water Treatment Plant	FINALPROD	0.63	Absence	Absence
160271	WJ022427	29-MAR-2018 08:15:00.00	Ain Deek & Teis Drinking Water Treatment Plant	RW	0.99	15.8	131.4
160272	WJ022427	29-MAR-2018 08:20:00.00	Ain Deek & Teis Drinking Water Treatment Plant	POST_UV	0.79	<1.0	<1.0
160273	WJ022427	29-MAR-2018 08:25:00.00	Ain Deek & Teis Drinking Water Treatment Plant	POST_FILTER	0.7	<1.0	<1.0
160274	WJ022427	29-MAR-2018 08:30:00.00	Ain Deek & Teis Drinking Water Treatment Plant	FINALPROD	0.62	Absence	Absence
160357	WJ022442	1-APR-2018 08:45:00.00	Ain Deek & Teis Drinking Water Treatment Plant	RW	0.95	42.8	461.1
160358	WJ022442	1-APR-2018 08:50:00.00	Ain Deek & Teis Drinking Water Treatment Plant	POST_UV	0.83	<1.0	<1.0
160359	WJ022442	1-APR-2018 08:55:00.00	Ain Deek & Teis Drinking Water Treatment Plant	POST_FILTER	0.76	<1.0	<1.0
160360	WJ022442	1-APR-2018 09:00:00.00	Ain Deek & Teis Drinking Water Treatment Plant	FINALPROD	0.64	Absence	Absence
160452	WJ022464	3-APR-2018 09:15:00.00	Ain Deek & Teis Drinking Water Treatment Plant	RW	0.93	13.4	141.4
160453	WJ022464	3-APR-2018 09:20:00.00	Ain Deek & Teis Drinking Water Treatment Plant	POST_UV	0.79	<1.0	<1.0
160454	WJ022464	3-APR-2018 09:25:00.00	Ain Deek & Teis Drinking Water Treatment Plant	POST_FILTER	0.65	<1.0	<1.0
160455	WJ022464	3-APR-2018 09:30:00.00	Ain Deek & Teis Drinking Water Treatment Plant	FINALPROD	0.62	Absence	Absence
160648	WJ022486	5-APR-2018 10:30:00.00	Ain Deek & Teis Drinking Water Treatment Plant	RW	1.05	6.3	18.3
160649	WJ022486	5-APR-2018 10:35:00.00	Ain Deek & Teis Drinking Water Treatment Plant	POST_UV	0.9	<1.0	<1.0
160650	WJ022486	5-APR-2018 10:40:00.00	Ain Deek & Teis Drinking Water Treatment Plant	POST_FILTER	0.79	<1.0	<1.0
160651	WJ022486	5-APR-2018 10:45:00.00	Ain Deek & Teis Drinking Water Treatment Plant	FINALPROD	0.75	Absence	Absence
160714	WJ022498	8-APR-2018 10:00:00.00	Ain Deek & Teis Drinking Water Treatment Plant	RW	0.97	21.6	88.4
160715	WJ022498	8-APR-2018 10:05:00.00	Ain Deek & Teis Drinking Water Treatment Plant	POST_UV	0.83	<1.0	<1.0
160716	WJ022498	8-APR-2018 10:10:00.00	Ain Deek & Teis Drinking Water Treatment Plant	POST_FILTER	0.66	<1.0	<1.0
160717	WJ022498	8-APR-2018 10:15:00.00	Ain Deek & Teis Drinking Water Treatment Plant	FINALPROD	0.63	Absence	Absence
160838	WJ022515	10-APR-2018 10:00:00.00	Ain Deek & Teis Drinking Water Treatment Plant	RW	0.97	79.8	185
160839	WJ022515	10-APR-2018 10:05:00.00	Ain Deek & Teis Drinking Water Treatment Plant	POST_UV	0.8	<1.0	<1.0
160840	WJ022515	10-APR-2018 10:10:00.00	Ain Deek & Teis Drinking Water Treatment Plant	POST_FILTER	0.77	<1.0	<1.0
160841	WJ022515	10-APR-2018 10:15:00.00	Ain Deek & Teis Drinking Water Treatment Plant	FINALPROD	0.7	Absence	Absence
160962	WJ022534	12-APR-2018 09:10:00.00	Ain Deek & Teis Drinking Water Treatment Plant	RW	1.11	15.8	73.8
160963	WJ022534	12-APR-2018 09:15:00.00	Ain Deek & Teis Drinking Water Treatment Plant	POST_UV	0.91	<1.0	<1.0
160964	WJ022534	12-APR-2018 09:20:00.00	Ain Deek & Teis Drinking Water Treatment Plant	POST_FILTER	0.83	<1.0	<1.0
160965	WJ022534	12-APR-2018 09:25:00.00	Ain Deek & Teis Drinking Water Treatment Plant	FINALPROD	0.8	Absence	Absence
161042	WJ022544	15-APR-2018 08:00:00.00	Ain Deek & Teis Drinking Water Treatment Plant	RW	0.94	2	45

161043	WJ022544	15-APR-2018 08:05:00.00	Ain Deek & Teis Drinking Water Treatment Plant	POST_UV	0.83	<1.0	<1.0
161044	WJ022544	15-APR-2018 08:10:00.00	Ain Deek & Teis Drinking Water Treatment Plant	POST_FILT	0.75	<1.0	1
161045	WJ022544	15-APR-2018 08:15:00.00	Ain Deek & Teis Drinking Water Treatment Plant	FINALPROD	0.73	Absence	Absence
161166	WJ022565	17-APR-2018 07:30:00.00	Ain Deek & Teis Drinking Water Treatment Plant	RW	0.93	1	22.6
161167	WJ022565	17-APR-2018 07:35:00.00	Ain Deek & Teis Drinking Water Treatment Plant	POST_UV	0.8	<1.0	<1.0
161168	WJ022565	17-APR-2018 07:40:00.00	Ain Deek & Teis Drinking Water Treatment Plant	POST_FILT	0.76	<1.0	<1.0
161169	WJ022565	17-APR-2018 07:45:00.00	Ain Deek & Teis Drinking Water Treatment Plant	FINALPROD	0.7	Absence	Absence
161331	WJ022590	19-APR-2018 08:30:00.00	Ain Deek & Teis Drinking Water Treatment Plant	RW	0.99	1	27.2
161332	WJ022590	19-APR-2018 08:35:00.00	Ain Deek & Teis Drinking Water Treatment Plant	POST_UV	0.85	<1.0	<1.0
161333	WJ022590	19-APR-2018 08:40:00.00	Ain Deek & Teis Drinking Water Treatment Plant	POST_FILT	0.7	<1.0	<1.0
161334	WJ022590	19-APR-2018 08:45:00.00	Ain Deek & Teis Drinking Water Treatment Plant	FINALPROD	0.66	Absence	Absence
161399	WJ022599	22-APR-2018 07:30:00.00	Ain Deek & Teis Drinking Water Treatment Plant	RW	0.97	13.5	38.9
161400	WJ022599	22-APR-2018 07:35:00.00	Ain Deek & Teis Drinking Water Treatment Plant	POST_UV	0.87	<1.0	<1.0
161401	WJ022599	22-APR-2018 07:40:00.00	Ain Deek & Teis Drinking Water Treatment Plant	POST_FILT	0.69	<1.0	<1.0
161402	WJ022599	22-APR-2018 07:45:00.00	Ain Deek & Teis Drinking Water Treatment Plant	FINALPROD	0.65	Absence	Absence




Sample No.	Job No.	Sampled date	Location	Treatment Stage	Turbidity	Escherichia coli	Total Coliforms
Ref :		Date :	التاريخ :		NTU	MPN/100ml	MPN/100ml
161538	WJ022621	24-APR-2018 08:30:00.00	Ain Deek & Teis Drinking Water Treatment Plant	RW	0.95	5.2	34.1
161539	WJ022621	24-APR-2018 08:35:00.00	Ain Deek & Teis Drinking Water Treatment Plant	POST_UV	0.9	<1.0	<1.0
161540	WJ022621	24-APR-2018 08:40:00.00	Ain Deek & Teis Drinking Water Treatment Plant	POST_FILT	0.81	<1.0	<1.0
161541	WJ022621	24-APR-2018 08:45:00.00	Ain Deek & Teis Drinking Water Treatment Plant	FINALPROD	0.75	Absence	Absence
161670	WJ022642	26-APR-2018 10:00:00.00	Ain Deek & Teis Drinking Water Treatment Plant	RW	0.93	9.8	39.9
161671	WJ022642	26-APR-2018 10:05:00.00	Ain Deek & Teis Drinking Water Treatment Plant	POST_UV	0.87	<1.0	<1.0
161672	WJ022642	26-APR-2018 10:10:00.00	Ain Deek & Teis Drinking Water Treatment Plant	POST_FILT	0.8	<1.0	<1.0
161673	WJ022642	26-APR-2018 10:15:00.00	Ain Deek & Teis Drinking Water Treatment Plant	FINALPROD	0.77	Absence	Absence
161739	WJ022650	29-APR-2018 08:00:00.00	Ain Deek & Teis Drinking Water Treatment Plant	RW	1.12	77.6	206.4
161740	WJ022650	29-APR-2018 08:05:00.00	Ain Deek & Teis Drinking Water Treatment Plant	POST_UV	0.98	<1.0	<1.0
161741	WJ022650	29-APR-2018 08:10:00.00	Ain Deek & Teis Drinking Water Treatment Plant	POST_FILT	0.9	<1.0	<1.0
161742	WJ022650	29-APR-2018 08:15:00.00	Ain Deek & Teis Drinking Water Treatment Plant	FINALPROD	0.85	Absence	Absence
161898	WJ022673	2-MAY-2018 07:35:00.00	Ain Deek & Teis Drinking Water Treatment Plant	RW	0.95	23.8	119.1
161899	WJ022673	2-MAY-2018 07:40:00.00	Ain Deek & Teis Drinking Water Treatment Plant	POST_UV	0.89	<1.0	<1.0
161900	WJ022673	2-MAY-2018 07:45:00.00	Ain Deek & Teis Drinking Water Treatment Plant	POST_FILT	0.8	<1.0	<1.0
161901	WJ022673	2-MAY-2018 07:50:00.00	Ain Deek & Teis Drinking Water Treatment Plant	FINALPROD	0.77	Absence	Absence
161952	WJ022684	3-MAY-2018 08:10:00.00	Ain Deek & Teis Drinking Water Treatment Plant	RW	1.03	27.9	130.9
161953	WJ022684	3-MAY-2018 08:15:00.00	Ain Deek & Teis Drinking Water Treatment Plant	POST_UV	0.92	<1.0	<1.0
161954	WJ022684	3-MAY-2018 08:20:00.00	Ain Deek & Teis Drinking Water Treatment Plant	POST_FILT	0.85	<1.0	<1.0
161955	WJ022684	3-MAY-2018 08:25:00.00	Ain Deek & Teis Drinking Water Treatment Plant	FINALPROD	0.8	Absence	Absence
162041	WJ022698	6-MAY-2018 06:55:00.00	Ain Deek & Teis Drinking Water Treatment Plant	RW	1.1	30.7	149.7
162042	WJ022698	6-MAY-2018 07:00:00.00	Ain Deek & Teis Drinking Water Treatment Plant	POST_UV	0.92	<1.0	<1.0
162043	WJ022698	6-MAY-2018 07:05:00.00	Ain Deek & Teis Drinking Water Treatment Plant	POST_FILT	0.87	<1.0	4.1
162044	WJ022698	6-MAY-2018 07:10:00.00	Ain Deek & Teis Drinking Water Treatment Plant	FINALPROD	0.82	Absence	Absence
162180	WJ022718	8-MAY-2018 07:10:00.00	Ain Deek & Teis Drinking Water Treatment Plant	RW	0.97	11	101.9
162181	WJ022718	8-MAY-2018 07:15:00.00	Ain Deek & Teis Drinking Water Treatment Plant	POST_UV	0.8	<1.0	<1.0
162182	WJ022718	8-MAY-2018 07:20:00.00	Ain Deek & Teis Drinking Water Treatment Plant	POST_FILT	0.76	<1.0	2
162183	WJ022718	8-MAY-2018 07:25:00.00	Ain Deek & Teis Drinking Water Treatment Plant	FINALPROD	0.69	Absence	Absence
162350	WJ022737	10-MAY-2018 09:10:00.00	Ain Deek & Teis Drinking Water Treatment Plant	RW	0.93	8.4	101.4
162351	WJ022737	10-MAY-2018 09:15:00.00	Ain Deek & Teis Drinking Water Treatment Plant	POST_UV	0.81	<1.0	<1.0
162352	WJ022737	10-MAY-2018 09:20:00.00	Ain Deek & Teis Drinking Water Treatment Plant	POST_FILT	0.77	<1.0	3.1
162353	WJ022737	10-MAY-2018 09:25:00.00	Ain Deek & Teis Drinking Water Treatment Plant	FINALPROD	0.73	Absence	Absence
162439	WJ022756	13-MAY-2018 08:00:00.00	Ain Deek & Teis Drinking Water Treatment Plant	RW	0.99	5.2	83.3
162440	WJ022756	13-MAY-2018 08:05:00.00	Ain Deek & Teis Drinking Water Treatment Plant	POST_UV	0.89	<1.0	<1.0
162441	WJ022756	13-MAY-2018 08:10:00.00	Ain Deek & Teis Drinking Water Treatment Plant	POST_FILT	0.81	<1.0	13.5
162442	WJ022756	13-MAY-2018 08:15:00.00	Ain Deek & Teis Drinking Water Treatment Plant	FINALPROD	0.75	Absence	Absence
162676	WJ022793	15-MAY-2018 07:10:00.00	Ain Deek & Teis Drinking Water Treatment Plant	RW	0.98	24.3	195.6
162677	WJ022793	15-MAY-2018 07:15:00.00	Ain Deek & Teis Drinking Water Treatment Plant	POST_UV	0.9	<1.0	<1.0
162678	WJ022793	15-MAY-2018 07:20:00.00	Ain Deek & Teis Drinking Water Treatment Plant	POST_FILT	0.82	<1.0	6.3
162679	WJ022793	15-MAY-2018 07:25:00.00	Ain Deek & Teis Drinking Water Treatment Plant	FINALPROD	0.78	Absence	Absence
162764	WJ022808	17-MAY-2018 09:45:00.00	Ain Deek & Teis Drinking Water Treatment Plant	RW	1.01	10.9	116.2
162765	WJ022808	17-MAY-2018 09:50:00.00	Ain Deek & Teis Drinking Water Treatment Plant	POST_UV	0.9	<1.0	<1.0
162766	WJ022808	17-MAY-2018 09:55:00.00	Ain Deek & Teis Drinking Water Treatment Plant	POST_FILT	0.81	<1.0	8.6
162767	WJ022808	17-MAY-2018 10:00:00.00	Ain Deek & Teis Drinking Water Treatment Plant	FINALPROD	0.77	Absence	Absence
162860	WJ022823	20-MAY-2018 08:40:00.00	Ain Deek & Teis Drinking Water Treatment Plant	RW	0.91	8.4	131.4
162861	WJ022823	20-MAY-2018 08:50:00.00	Ain Deek & Teis Drinking Water Treatment Plant	POST_UV	0.82	<1.0	<1.0
162862	WJ022823	20-MAY-2018 08:55:00.00	Ain Deek & Teis Drinking Water Treatment Plant	POST_UF	0.77	<1.0	2
162863	WJ022823	20-MAY-2018 09:05:00.00	Ain Deek & Teis Drinking Water Treatment Plant	FINALPROD	0.71	Absence	Absence
162951	WJ022844	22-MAY-2018 08:00:00.00	Ain Deek & Teis Drinking Water Treatment Plant	RW	0.94	12.1	198.9
162952	WJ022844	22-MAY-2018 08:05:00.00	Ain Deek & Teis Drinking Water Treatment Plant	POST_UV	0.89	<1.0	<1.0
162953	WJ022844	22-MAY-2018 08:10:00.00	Ain Deek & Teis Drinking Water Treatment Plant	POST_FILT	0.81	<1.0	<1.0
162954	WJ022844	22-MAY-2018 08:15:00.00	Ain Deek & Teis Drinking Water Treatment Plant	FINALPROD	1.5	Absence	Absence
163093	WJ022872	24-MAY-2018 09:05:00.00	Ain Deek & Teis Drinking Water Treatment Plant	RW	0.94	6.3	165
163094	WJ022872	24-MAY-2018 09:10:00.00	Ain Deek & Teis Drinking Water Treatment Plant	POST_UV	0.9	<1.0	<1.0
163095	WJ022872	24-MAY-2018 09:15:00.00	Ain Deek & Teis Drinking Water Treatment Plant	POST_FILT	0.81	<1.0	1
163096	WJ022872	24-MAY-2018 09:20:00.00	Ain Deek & Teis Drinking Water Treatment Plant	FINALPROD	0.75	Absence	Absence
163130	WJ022878	27-MAY-2018 09:00:00.00	Ain Deek & Teis Drinking Water Treatment Plant	RW	0.94	4.1	57.3
163131	WJ022878	27-MAY-2018 09:05:00.00	Ain Deek & Teis Drinking Water Treatment Plant	POST_UV	0.9	<1.0	<1.0

ID	WJID	Date	Plant	Process	Value	Limit	Limit
163132	WJ022878	27-MAY-2018 09:10:00.00	Ain Deek & Teis Drinking Water Treatment Plant	POST_FILTER			
163133	WJ022878	27-MAY-2018 09:15:00.00	Ain Deek & Teis Drinking Water Treatment Plant	FINALPROD	0.83	<1.0	<1.0
163298	WJ022899	29-MAY-2018 08:00:00.00	Ain Deek & Teis Drinking Water Treatment Plant	RW	0.78	Absence	Absence
163299	WJ022899	29-MAY-2018 08:05:00.00	Ain Deek & Teis Drinking Water Treatment Plant	RW	0.91	17.5	85.5
163300	WJ022899	29-MAY-2018 08:10:00.00	Ain Deek & Teis Drinking Water Treatment Plant	POST_UV	0.84	<1.0	<1.0
163301	WJ022899	29-MAY-2018 08:15:00.00	Ain Deek & Teis Drinking Water Treatment Plant	POST_FILTER	0.8	<1.0	2
163407	WJ022913	31-MAY-2018 09:35:00.00	Ain Deek & Teis Drinking Water Treatment Plant	FINALPROD	0.77	Absence	Absence
163408	WJ022913	31-MAY-2018 09:45:00.00	Ain Deek & Teis Drinking Water Treatment Plant	Raw	0.95	104.6	435.2
163409	WJ022913	31-MAY-2018 09:50:00.00	Ain Deek & Teis Drinking Water Treatment Plant	POST_UV	0.81	<1.0	<1.0
163410	WJ022913	31-MAY-2018 10:00:00.00	Ain Deek & Teis Drinking Water Treatment Plant	POST_FILTER	0.77	<1.0	1
163457	WJ022922	3-JUN-2018 08:50:00.00	Ain Deek & Teis Drinking Water Treatment Plant	FINALPROD	0.73	Absence	Absence
163459	WJ022922	3-JUN-2018 09:10:00.00	Ain Deek & Teis Drinking Water Treatment Plant	RW	0.95	32.9	517.2
163460	WJ022922	3-JUN-2018 09:15:00.00	Ain Deek & Teis Drinking Water Treatment Plant	POST_UV	0.81	<1.0	<1.0
163461	WJ022922	3-JUN-2018 09:20:00.00	Ain Deek & Teis Drinking Water Treatment Plant	POST_FILTER	0.74	<1.0	<1.0
163602	WJ022944	5-JUN-2018 10:05:00.00	Ain Deek & Teis Drinking Water Treatment Plant	FINALPROD	0.7	Absence	Absence
163603	WJ022944	5-JUN-2018 10:10:00.00	Ain Deek & Teis Drinking Water Treatment Plant	RW	0.92	14.4	461.1
163604	WJ022944	5-JUN-2018 10:15:00.00	Ain Deek & Teis Drinking Water Treatment Plant	POST_UV	0.85	<1.0	<1.0
163605	WJ022944	5-JUN-2018 10:20:00.00	Ain Deek & Teis Drinking Water Treatment Plant	POST_FILTER	0.71	<1.0	<1.0
163735	WJ022968	7-JUN-2018 09:00:00.00	Ain Deek & Teis Drinking Water Treatment Plant	FINALPROD	0.66	Absence	Absence
163736	WJ022968	7-JUN-2018 09:10:00.00	Ain Deek & Teis Drinking Water Treatment Plant	RW	0.87	5.2	88.4
163737	WJ022968	7-JUN-2018 09:10:00.00	Ain Deek & Teis Drinking Water Treatment Plant	POST_UV	0.75	<1.0	<1.0
163738	WJ022968	7-JUN-2018 09:15:00.00	Ain Deek & Teis Drinking Water Treatment Plant	POST_FILTER	0.72	<1.0	<1.0
163844	WJ022987	10-JUN-2018 10:15:00.00	Ain Deek & Teis Drinking Water Treatment Plant	FINALPROD	0.64	Absence	Absence
163845	WJ022987	10-JUN-2018 10:20:00.00	Ain Deek & Teis Drinking Water Treatment Plant	RW	0.91	8.6	49.5
163846	WJ022987	10-JUN-2018 10:25:00.00	Ain Deek & Teis Drinking Water Treatment Plant	POST_UV	0.87	<1.0	<1.0
163847	WJ022987	10-JUN-2018 10:30:00.00	Ain Deek & Teis Drinking Water Treatment Plant	POST_FILTER	0.73	<1.0	<1.0
163914	WJ023001	12-JUN-2018 09:20:00.00	Ain Deek & Teis Drinking Water Treatment Plant	FINALPROD	0.7	Absence	Absence
163915	WJ023001	12-JUN-2018 09:25:00.00	Ain Deek & Teis Drinking Water Treatment Plant	RW	0.94	110.6	344.8
163916	WJ023001	12-JUN-2018 09:30:00.00	Ain Deek & Teis Drinking Water Treatment Plant	POST_UV	0.8	<1.0	<1.0
163917	WJ023001	12-JUN-2018 09:35:00.00	Ain Deek & Teis Drinking Water Treatment Plant	POST_FILTER	0.71	<1.0	<1.0
164038	WJ023027	14-JUN-2018 10:10:00.00	Ain Deek & Teis Drinking Water Treatment Plant	FINALPROD	0.67	Absence	Absence
164039	WJ023027	14-JUN-2018 10:15:00.00	Ain Deek & Teis Drinking Water Treatment Plant	RW	0.91	26.5	102.2
164040	WJ023027	14-JUN-2018 10:20:00.00	Ain Deek & Teis Drinking Water Treatment Plant	POST_UV	0.81	<1.0	<1.0
164041	WJ023027	14-JUN-2018 10:25:00.00	Ain Deek & Teis Drinking Water Treatment Plant	POST_FILTER	0.74	<1.0	2
164121	WJ023037	19-JUN-2018 09:00:00.00	Ain Deek & Teis Drinking Water Treatment Plant	FINALPROD	0.66	Absence	Absence
164122	WJ023037	19-JUN-2018 09:05:00.00	Ain Deek & Teis Drinking Water Treatment Plant	RW	0.9	57.3	248.1
164123	WJ023037	19-JUN-2018 09:10:00.00	Ain Deek & Teis Drinking Water Treatment Plant	POST_UV	0.79	<1.0	<1.0
164124	WJ023037	19-JUN-2018 09:15:00.00	Ain Deek & Teis Drinking Water Treatment Plant	POST_FILTER	0.73	<1.0	<1.0
164189	WJ023049	21-JUN-2018 08:30:00.00	Ain Deek & Teis Drinking Water Treatment Plant	FINALPROD	0.64	Absence	Absence
164190	WJ023049	21-JUN-2018 08:35:00.00	Ain Deek & Teis Drinking Water Treatment Plant	RW	0.89	18.3	121.1
164191	WJ023049	21-JUN-2018 08:40:00.00	Ain Deek & Teis Drinking Water Treatment Plant	POST_UV	0.82	<1.0	<1.0
164192	WJ023049	21-JUN-2018 08:45:00.00	Ain Deek & Teis Drinking Water Treatment Plant	POST_FILTER	0.71	<1.0	2
164283	WJ023066	24-JUN-2018 07:15:00.00	Ain Deek & Teis Drinking Water Treatment Plant	FINALPROD	0.69	Absence	Absence
164284	WJ023066	24-JUN-2018 07:20:00.00	Ain Deek & Teis Drinking Water Treatment Plant	RW	0.94	6.3	39.9
164285	WJ023066	24-JUN-2018 07:25:00.00	Ain Deek & Teis Drinking Water Treatment Plant	POST_UV	0.83	<1.0	<1.0
164286	WJ023066	24-JUN-2018 08:30:00.00	Ain Deek & Teis Drinking Water Treatment Plant	POST_FILTER	0.76	<1.0	6.3
164478	WJ023092	26-JUN-2018 08:15:00.00	Ain Deek & Teis Drinking Water Treatment Plant	FINALPROD	0.7	Absence	Absence
164479	WJ023092	26-JUN-2018 08:20:00.00	Ain Deek & Teis Drinking Water Treatment Plant	RW	0.94	2	42.6
164480	WJ023092	26-JUN-2018 08:25:00.00	Ain Deek & Teis Drinking Water Treatment Plant	POST_UV	0.93	4.1	38.3
164481	WJ023092	26-JUN-2018 08:30:00.00	Ain Deek & Teis Drinking Water Treatment Plant	POST_FILTER	0.79	7.5	37.9
164608	WJ023112	28-JUN-2018 07:15:00.00	Ain Deek & Teis Drinking Water Treatment Plant	FINALPROD	0.72	Absence	Absence
164609	WJ023112	28-JUN-2018 07:20:00.00	Ain Deek & Teis Drinking Water Treatment Plant	RW	0.9	4.1	93.3
164610	WJ023112	28-JUN-2018 07:25:00.00	Ain Deek & Teis Drinking Water Treatment Plant	POST_UV	0.82	<1.0	<1.0
164611	WJ023112	28-JUN-2018 07:30:00.00	Ain Deek & Teis Drinking Water Treatment Plant	POST_FILTER	0.77	<1.0	1
164689	WJ023126	1-JUL-2018 07:55:00.00	Ain Deek & Teis Drinking Water Treatment Plant	FINALPROD	0.7	Absence	Absence
164690	WJ023126	1-JUL-2018 08:00:00.00	Ain Deek & Teis Drinking Water Treatment Plant	RW	0.83	19.7	272.3
164691	WJ023126	1-JUL-2018 08:05:00.00	Ain Deek & Teis Drinking Water Treatment Plant	POST_UV	0.8	<1.0	<1.0
164692	WJ023126	1-JUL-2018 08:10:00.00	Ain Deek & Teis Drinking Water Treatment Plant	POST_FILTER	0.74	<1.0	5.2
164894	WJ023153	3-JUL-2018 07:15:00.00	Ain Deek & Teis Drinking Water Treatment Plant	FINALPROD	0.68	Absence	Absence
164895	WJ023153	3-JUL-2018 07:20:00.00	Ain Deek & Teis Drinking Water Treatment Plant	RW	0.94	6.2	101.7
164896	WJ023153	3-JUL-2018 07:25:00.00	Ain Deek & Teis Drinking Water Treatment Plant	POST_UV	0.89	<1.0	<1.0
164897	WJ023153	3-JUL-2018 07:30:00.00	Ain Deek & Teis Drinking Water Treatment Plant	POST_FILTER	0.82	<1.0	9.8
165050	WJ023178	5-JUL-2018 08:15:00.00	Ain Deek & Teis Drinking Water Treatment Plant	FINALPROD	0.75	Absence	Absence
165051	WJ023178	5-JUL-2018 08:20:00.00	Ain Deek & Teis Drinking Water Treatment Plant	RW	0.77	28.7	272.3
165052	WJ023178	5-JUL-2018 08:25:00.00	Ain Deek & Teis Drinking Water Treatment Plant	POST_UV	0.87	<1.0	<1.0
165053	WJ023178	5-JUL-2018 08:30:00.00	Ain Deek & Teis Drinking Water Treatment Plant	POST_FILTER	0.83	<1.0	3.1
165072	WJ023184	8-JUL-2018 08:15:00.00	Ain Deek & Teis Drinking Water Treatment Plant	FINALPROD	0.78	Absence	Absence
165073	WJ023184	8-JUL-2018 08:20:00.00	Ain Deek & Teis Drinking Water Treatment Plant	RW	0.93	2	133.4
				POST_UV	0.87	<1.0	<1.0

Yarmouk Water Company
 Irbid, Baghdad St. P.O.Box 378, Irbid 21110 Jordan
 Tel: +962 2 727 5477 Fax: +962 2 727 0707
 Website :- www.yw.com.jo Email : Info@yw.com.jo

شركة مياه اليرموك
 اربد ، شارع بغداد ص. ب. 378 اربد 21110 الاردن
 هاتف :- + 96227275477 فاكس :- + 96227270707
 الموقع الالكتروني :- www.yw.com.jo البريد الالكتروني :- Info@yw.com.jo

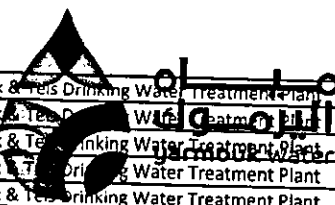



Ref	WJID	Date	Plant	Process	Value	Limit	Unit
165074	WJ023184	8-JUL-2018 08:25:00.00	Ain Deek & Teis Drinking Water Treatment Plant	POST_FILTER	0.81	<1.0	7.5
165075	WJ023184	8-JUL-2018 08:30:00.00	Ain Deek & Teis Drinking Water Treatment Plant	FINALPROD	0.75	Absence	Absence
165295	WJ023224	11-JUL-2018 09:10:00.00	Ain Deek & Teis Drinking Water Treatment Plant	RW	0.98	2	113.7
165296	WJ023224	11-JUL-2018 09:15:00.00	Ain Deek & Teis Drinking Water Treatment Plant	POST_UV	0.87	<1.0	<1.0
165297	WJ023224	11-JUL-2018 09:20:00.00	Ain Deek & Teis Drinking Water Treatment Plant	POST_FILTER	0.81	<1.0	2
165298	WJ023224	11-JUL-2018 09:25:00.00	Ain Deek & Teis Drinking Water Treatment Plant	FINALPROD	0.76	Absence	Absence
165387	WJ023239	12-JUL-2018 09:55:00.00	Ain Deek & Teis Drinking Water Treatment Plant	RW	0.93	29.5	344.8
165388	WJ023239	12-JUL-2018 10:00:00.00	Ain Deek & Teis Drinking Water Treatment Plant	POST_UV	0.85	<1.0	<1.0
165389	WJ023239	12-JUL-2018 10:05:00.00	Ain Deek & Teis Drinking Water Treatment Plant	POST_FILTER	0.79	<1.0	1
165390	WJ023239	12-JUL-2018 10:10:00.00	Ain Deek & Teis Drinking Water Treatment Plant	FINALPROD	0.77	Absence	Absence
165509	WJ023258	15-JUL-2018 08:20:00.00	Ain Deek & Teis Drinking Water Treatment Plant	RW	0.89	12.2	77.1
165510	WJ023258	15-JUL-2018 08:25:00.00	Ain Deek & Teis Drinking Water Treatment Plant	POST_UV	0.82	<1.0	<1.0
165511	WJ023258	15-JUL-2018 08:35:00.00	Ain Deek & Teis Drinking Water Treatment Plant	FINALPROD	0.69	Absence	Absence
165637	WJ023282	17-JUL-2018 07:40:00.00	Ain Deek & Teis Drinking Water Treatment Plant	RW	0.95	6.2	60.2
165638	WJ023282	17-JUL-2018 07:45:00.00	Ain Deek & Teis Drinking Water Treatment Plant	POST_UV	0.83	<1.0	<1.0
165639	WJ023282	17-JUL-2018 07:50:00.00	Ain Deek & Teis Drinking Water Treatment Plant	POST_FILTER	0.79	<1.0	1
165640	WJ023282	17-JUL-2018 07:55:00.00	Ain Deek & Teis Drinking Water Treatment Plant	FINALPROD	0.71	Absence	Absence
165709	WJ023297	22-JUL-2018 07:30:00.00	Ain Deek & Teis Drinking Water Treatment Plant	RW	0.88	1	61.6
165710	WJ023297	22-JUL-2018 07:35:00.00	Ain Deek & Teis Drinking Water Treatment Plant	POST_UV	0.83	<1.0	<1.0
165711	WJ023297	22-JUL-2018 07:40:00.00	Ain Deek & Teis Drinking Water Treatment Plant	POST_FILTER	0.72	<1.0	4.1
165712	WJ023297	22-JUL-2018 07:45:00.00	Ain Deek & Teis Drinking Water Treatment Plant	FINALPROD	0.65	Absence	Absence
165777	WJ023307	22-JUL-2018 07:00:00.00	Ain Deek & Teis Drinking Water Treatment Plant	RW	0.9	1	41.1
165778	WJ023307	22-JUL-2018 07:05:00.00	Ain Deek & Teis Drinking Water Treatment Plant	POST_UV	0.82	<1.0	<1.0
165779	WJ023307	22-JUL-2018 07:10:00.00	Ain Deek & Teis Drinking Water Treatment Plant	POST_FILTER	0.75	<1.0	<1.0
165780	WJ023307	22-JUL-2018 07:15:00.00	Ain Deek & Teis Drinking Water Treatment Plant	FINALPROD	0.7	Absence	Absence
165901	WJ023325	24-JUL-2018 07:30:00.00	Ain Deek & Teis Drinking Water Treatment Plant	RW	0.8	<1.0	25.3
165902	WJ023325	24-JUL-2018 07:35:00.00	Ain Deek & Teis Drinking Water Treatment Plant	POST_UV	0.75	<1.0	<1.0
165903	WJ023325	24-JUL-2018 07:40:00.00	Ain Deek & Teis Drinking Water Treatment Plant	POST_FILTER	0.69	<1.0	<1.0
165904	WJ023325	24-JUL-2018 07:45:00.00	Ain Deek & Teis Drinking Water Treatment Plant	FINALPROD	0.63	Absence	Absence
166040	WJ023348	26-JUL-2018 08:00:00.00	Ain Deek & Teis Drinking Water Treatment Plant	RW	0.93	2	58.3
166041	WJ023348	26-JUL-2018 08:05:00.00	Ain Deek & Teis Drinking Water Treatment Plant	POST_UV	0.87	<1.0	<1.0
166042	WJ023348	26-JUL-2018 08:10:00.00	Ain Deek & Teis Drinking Water Treatment Plant	POST_FILTER	0.79	<1.0	1
166043	WJ023348	26-JUL-2018 08:15:00.00	Ain Deek & Teis Drinking Water Treatment Plant	FINALPROD	0.75	Absence	Absence
166109	WJ023358	29-JUL-2018 07:45:00.00	Ain Deek & Teis Drinking Water Treatment Plant	RW	0.95	2	32.7
166110	WJ023358	29-JUL-2018 07:50:00.00	Ain Deek & Teis Drinking Water Treatment Plant	POST_UV	0.83	<1.0	<1.0
166111	WJ023358	29-JUL-2018 08:00:00.00	Ain Deek & Teis Drinking Water Treatment Plant	POST_FILTER	0.78	<1.0	<1.0
166112	WJ023358	29-JUL-2018 08:05:00.00	Ain Deek & Teis Drinking Water Treatment Plant	FINALPROD	0.73	Absence	Absence
166213	WJ023377	31-JUL-2018 07:35:00.00	Ain Deek & Teis Drinking Water Treatment Plant	RW	0.89	7.5	387.3
166214	WJ023377	31-JUL-2018 07:40:00.00	Ain Deek & Teis Drinking Water Treatment Plant	POST_UV	0.8	<1.0	<1.0
166215	WJ023377	31-JUL-2018 07:45:00.00	Ain Deek & Teis Drinking Water Treatment Plant	POST_FILTER	0.72	<1.0	<1.0
166216	WJ023377	31-JUL-2018 07:50:00.00	Ain Deek & Teis Drinking Water Treatment Plant	FINALPROD	0.69	Absence	Absence
166381	WJ023406	2-AUG-2018 09:25:00.00	Ain Deek & Teis Drinking Water Treatment Plant	RW	0.91	18.9	113
166382	WJ023406	2-AUG-2018 09:30:00.00	Ain Deek & Teis Drinking Water Treatment Plant	POST_UV	0.87	<1.0	<1.0
166383	WJ023406	2-AUG-2018 09:35:00.00	Ain Deek & Teis Drinking Water Treatment Plant	POST_FILTER	0.82	<1.0	<1.0
166384	WJ023406	2-AUG-2018 09:40:00.00	Ain Deek & Teis Drinking Water Treatment Plant	FINALPROD	0.77	Absence	Absence
166438	WJ023409	5-AUG-2018 08:00:00.00	Ain Deek & Teis Drinking Water Treatment Plant	RW	0.95	30.9	114.5
166439	WJ023409	5-AUG-2018 08:05:00.00	Ain Deek & Teis Drinking Water Treatment Plant	POST_UV	0.93	<1.0	<1.0
166451	WJ023409	5-AUG-2018 10:38:00.00	Ain Deek & Teis Drinking Water Treatment Plant	POST_FILTER	0.87	<1.0	2
166452	WJ023409	5-AUG-2018 08:15:00.00	Ain Deek & Teis Drinking Water Treatment Plant	FINALPROD	0.78	Absence	Absence
166618	WJ023449	7-AUG-2018 08:30:00.00	Ain Deek & Teis Drinking Water Treatment Plant	RW	0.91	56.5	157.6
166619	WJ023449	7-AUG-2018 08:40:00.00	Ain Deek & Teis Drinking Water Treatment Plant	POST_UV	0.82	<1.0	<1.0
166620	WJ023449	7-AUG-2018 08:45:00.00	Ain Deek & Teis Drinking Water Treatment Plant	POST_FILTER	0.77	<1.0	2
166621	WJ023449	7-AUG-2018 08:50:00.00	Ain Deek & Teis Drinking Water Treatment Plant	FINALPROD	0.74	Absence	Absence
166761	WJ023469	9-AUG-2018 10:15:00.00	Ain Deek & Teis Drinking Water Treatment Plant	RW	0.9	17.3	71.2
166762	WJ023469	9-AUG-2018 10:20:00.00	Ain Deek & Teis Drinking Water Treatment Plant	POST_UV	0.81	<1.0	<1.0
166763	WJ023469	9-AUG-2018 10:25:00.00	Ain Deek & Teis Drinking Water Treatment Plant	POST_FILTER	0.73	<1.0	<1.0
166764	WJ023469	9-AUG-2018 10:30:00.00	Ain Deek & Teis Drinking Water Treatment Plant	FINALPROD	0.69	Absence	Absence
166833	WJ023479	12-AUG-2018 08:05:00.00	Ain Deek & Teis Drinking Water Treatment Plant	RW	0.96	11	79.4
166834	WJ023479	12-AUG-2018 08:10:00.00	Ain Deek & Teis Drinking Water Treatment Plant	POST_UV	0.86	<1.0	<1.0
166835	WJ023479	12-AUG-2018 08:15:00.00	Ain Deek & Teis Drinking Water Treatment Plant	POST_FILTER	0.8	<1.0	<1.0
166836	WJ023479	12-AUG-2018 08:20:00.00	Ain Deek & Teis Drinking Water Treatment Plant	FINALPROD	0.77	Absence	presence
166913	WJ023493	13-AUG-2018 08:10:00.00	Ain Deek & Teis Drinking Water Treatment Plant	FINALPROD	0.75	Absence	Absence
166914	WJ023493	13-AUG-2018 08:15:00.00	Ain Deek & Teis Drinking Water Treatment Plant	FINALPROD	0.75	Absence	Absence
167009	WJ023507	14-AUG-2018 09:30:00.00	Ain Deek & Teis Drinking Water Treatment Plant	RW	0.94	<1.0	61.7
167010	WJ023507	14-AUG-2018 09:35:00.00	Ain Deek & Teis Drinking Water Treatment Plant	POST_UV	0.87	<1.0	<1.0
167011	WJ023507	14-AUG-2018 09:40:00.00	Ain Deek & Teis Drinking Water Treatment Plant	POST_FILTER	0.78	<1.0	<1.0
167012	WJ023507	14-AUG-2018 09:45:00.00	Ain Deek & Teis Drinking Water Treatment Plant	FINALPROD	0.72	Absence	Absence
167197	WJ023542	16-AUG-2018 09:00:00.00	Ain Deek & Teis Drinking Water Treatment Plant	RW	0.89	6.3	96

Yarmouk Water Company
 Irbid, Baghdad St. P.O.Box 378,Irbid 21110 Jordan
 Tel: +962 2 727 5477 Fax:+962 2 727 0707
 Website :- www.yw.com.jo Email : Info@yw.com.jo

شركة مياه اليرموك
 اربد، شارع بغداد ص. ب. 378 اربد 21110 الاردن
 هاتف :- +96227275477 فاكس :- +96227270707
 الموقع الالكتروني :- www.yw.com.jo البريد الالكتروني :- Info@yw.com.jo

169199	WJ023852	25-SEP-2018 10:35:00.00	Ain Deek & Teis Drinking Water Treatment Plant	POST UV	0.85	3.1	71.7
169200	WJ023852	25-SEP-2018 10:40:00.00	Ain Deek & Teis Drinking Water Treatment Plant	POST FILT	0.81	2	58.1
169357	WJ023879	27-SEP-2018 10:15:00.00	Ain Deek & Teis Drinking Water Treatment Plant	FINALPROD	0.75	Absence	Absence
169358	WJ023879	27-SEP-2018 10:20:00.00	Ain Deek & Teis Drinking Water Treatment Plant	POST UV	0.93	1	224.7
169359	WJ023879	27-SEP-2018 10:25:00.00	Ain Deek & Teis Drinking Water Treatment Plant	POST FILT	0.87	<1.0	<1.0
169360	WJ023884	30-SEP-2018 12:00:00.00	Ain Deek & Teis Drinking Water Treatment Plant	FINALPROD	0.75	Absence	Absence
169391	WJ023884	30-SEP-2018 12:05:00.00	Ain Deek & Teis Drinking Water Treatment Plant	POST UV	0.96	52	1222.3
169392	WJ023884	30-SEP-2018 12:10:00.00	Ain Deek & Teis Drinking Water Treatment Plant	POST FILT	0.89	<1.0	<1.0
169393	WJ023884	30-SEP-2018 12:20:00.00	Ain Deek & Teis Drinking Water Treatment Plant	FINALPROD	0.77	<1.0	<1.0
169550	WJ023911	2-OCT-2018 08:40:00.00	Ain Deek & Teis Drinking Water Treatment Plant	POST UV	0.71	Absence	Absence
169551	WJ023911	2-OCT-2018 08:45:00.00	Ain Deek & Teis Drinking Water Treatment Plant	POST FILT	0.88	231	1046.2
169552	WJ023911	2-OCT-2018 08:50:00.00	Ain Deek & Teis Drinking Water Treatment Plant	POST UV	0.82	<1.0	<1.0
169553	WJ023911	2-OCT-2018 08:55:00.00	Ain Deek & Teis Drinking Water Treatment Plant	POST FILT	0.75	<1.0	<1.0
169720	WJ023937	4-OCT-2018 08:25:00.00	Ain Deek & Teis Drinking Water Treatment Plant	FINALPROD	0.69	Absence	Absence
169721	WJ023937	4-OCT-2018 08:30:00.00	Ain Deek & Teis Drinking Water Treatment Plant	POST UV	0.87	1986.3	2419.6
169722	WJ023937	4-OCT-2018 08:35:00.00	Ain Deek & Teis Drinking Water Treatment Plant	POST FILT	0.8	<1.0	<1.0
169723	WJ023937	4-OCT-2018 08:40:00.00	Ain Deek & Teis Drinking Water Treatment Plant	POST UV	0.79	<1.0	<1.0
169869	WJ023958	7-OCT-2018 08:20:00.00	Ain Deek & Teis Drinking Water Treatment Plant	FINALPROD	0.73	Absence	Absence
169870	WJ023958	7-OCT-2018 08:25:00.00	Ain Deek & Teis Drinking Water Treatment Plant	POST UV	0.88	770.1	2419.6
169871	WJ023958	7-OCT-2018 08:30:00.00	Ain Deek & Teis Drinking Water Treatment Plant	POST FILT	0.77	<1.0	<1.0
169872	WJ023958	7-OCT-2018 08:35:00.00	Ain Deek & Teis Drinking Water Treatment Plant	FINALPROD	0.74	<1.0	<1.0
169882	WJ023981	9-OCT-2018 08:40:00.00	Ain Deek & Teis Drinking Water Treatment Plant	POST UV	0.87	1119.9	2419.6
169884	WJ023981	9-OCT-2018 08:50:00.00	Ain Deek & Teis Drinking Water Treatment Plant	POST FILT	0.8	<1.0	<1.0
169885	WJ023981	9-OCT-2018 08:55:00.00	Ain Deek & Teis Drinking Water Treatment Plant	POST UV	0.78	<1.0	<1.0
170190	WJ024013	11-OCT-2018 09:20:00.00	Ain Deek & Teis Drinking Water Treatment Plant	FINALPROD	0.74	Absence	Absence
170191	WJ024013	11-OCT-2018 09:25:00.00	Ain Deek & Teis Drinking Water Treatment Plant	POST UV	0.87	435.2	1119.9
170192	WJ024013	11-OCT-2018 09:30:00.00	Ain Deek & Teis Drinking Water Treatment Plant	POST FILT	0.8	<1.0	<1.0
170193	WJ024013	11-OCT-2018 09:35:00.00	Ain Deek & Teis Drinking Water Treatment Plant	POST UV	0.75	<1.0	<1.0
170283	WJ024026	14-OCT-2018 08:30:00.00	Ain Deek & Teis Drinking Water Treatment Plant	FINALPROD	0.72	Absence	Absence
170284	WJ024026	14-OCT-2018 08:35:00.00	Ain Deek & Teis Drinking Water Treatment Plant	POST UV	0.9	238.2	866.4
170285	WJ024026	14-OCT-2018 08:40:00.00	Ain Deek & Teis Drinking Water Treatment Plant	POST FILT	0.86	<1.0	<1.0
170286	WJ024026	14-OCT-2018 08:45:00.00	Ain Deek & Teis Drinking Water Treatment Plant	POST UV	0.77	<1.0	<1.0
170423	WJ024054	16-OCT-2018 08:55:00.00	Ain Deek & Teis Drinking Water Treatment Plant	FINALPROD	0.75	Absence	Absence
170424	WJ024054	16-OCT-2018 09:00:00.00	Ain Deek & Teis Drinking Water Treatment Plant	POST UV	0.87	59.4	325.5
170425	WJ024054	16-OCT-2018 09:05:00.00	Ain Deek & Teis Drinking Water Treatment Plant	POST FILT	0.79	<1.0	<1.0
170426	WJ024054	16-OCT-2018 09:10:00.00	Ain Deek & Teis Drinking Water Treatment Plant	POST UV	0.75	<1.0	<1.0
170594	WJ024082	18-OCT-2018 08:40:00.00	Ain Deek & Teis Drinking Water Treatment Plant	FINALPROD	0.71	Absence	Absence
170595	WJ024082	18-OCT-2018 08:45:00.00	Ain Deek & Teis Drinking Water Treatment Plant	POST UV	0.87	248.9	648.8
170596	WJ024082	18-OCT-2018 08:50:00.00	Ain Deek & Teis Drinking Water Treatment Plant	POST FILT	0.83	<1.0	<1.0
170598	WJ024082	18-OCT-2018 09:00:00.00	Ain Deek & Teis Drinking Water Treatment Plant	POST UV	0.77	<1.0	<1.0
170633	WJ024093	21-OCT-2018 08:25:00.00	Ain Deek & Teis Drinking Water Treatment Plant	FINALPROD	0.73	Absence	Absence
170674	WJ024093	21-OCT-2018 08:30:00.00	Ain Deek & Teis Drinking Water Treatment Plant	POST UV	0.87	866.4	2419.6
170675	WJ024093	21-OCT-2018 08:35:00.00	Ain Deek & Teis Drinking Water Treatment Plant	POST FILT	0.82	<1.0	<1.0
170676	WJ024093	21-OCT-2018 08:40:00.00	Ain Deek & Teis Drinking Water Treatment Plant	POST UV	0.75	<1.0	<1.0
170808	WJ024113	23-OCT-2018 09:00:00.00	Ain Deek & Teis Drinking Water Treatment Plant	FINALPROD	0.69	Absence	Absence
170810	WJ024113	23-OCT-2018 09:05:00.00	Ain Deek & Teis Drinking Water Treatment Plant	POST UV	0.97	248.1	920.8
170811	WJ024113	23-OCT-2018 09:15:00.00	Ain Deek & Teis Drinking Water Treatment Plant	POST FILT	0.88	<1.0	<1.0
170952	WJ024139	25-OCT-2018 09:05:00.00	Ain Deek & Teis Drinking Water Treatment Plant	FINALPROD	0.77	Absence	Absence
170953	WJ024139	25-OCT-2018 09:10:00.00	Ain Deek & Teis Drinking Water Treatment Plant	POST UV	0.93	198.9	1203.3
170954	WJ024139	25-OCT-2018 09:15:00.00	Ain Deek & Teis Drinking Water Treatment Plant	POST FILT	0.87	<1.0	<1.0
170955	WJ024139	25-OCT-2018 09:20:00.00	Ain Deek & Teis Drinking Water Treatment Plant	POST UV	0.74	<1.0	<1.0
170970	WJ024141	28-OCT-2018 09:10:00.00	Ain Deek & Teis Drinking Water Treatment Plant	FINALPROD	0.67	Absence	Absence
170971	WJ024141	28-OCT-2018 09:15:00.00	Ain Deek & Teis Drinking Water Treatment Plant	POST UV	0.98	3255.0*	17329.0*
170972	WJ024141	28-OCT-2018 09:20:00.00	Ain Deek & Teis Drinking Water Treatment Plant	POST FILT	0.9	<1.0	<1.0
170973	WJ024141	28-OCT-2018 09:25:00.00	Ain Deek & Teis Drinking Water Treatment Plant	POST UV	0.81	<1.0	<1.0
171138	WJ024172	30-OCT-2018 08:35:00.00	Ain Deek & Teis Drinking Water Treatment Plant	FINALPROD	0.79	Absence	Absence
171139	WJ024172	30-OCT-2018 08:40:00.00	Ain Deek & Teis Drinking Water Treatment Plant	POST UV	1.09	410.6*	1986.3*
171140	WJ024172	30-OCT-2018 08:50:00.00	Ain Deek & Teis Drinking Water Treatment Plant	POST FILT	0.93	<1.0	<1.0
171232	WJ024194	1-NOV-2018 08:50:00.00	Ain Deek & Teis Drinking Water Treatment Plant	FINALPROD	0.89	Absence	Absence
171233	WJ024194	1-NOV-2018 08:55:00.00	Ain Deek & Teis Drinking Water Treatment Plant	POST UV	0.93	1119.9*	2419.6*
171234	WJ024194	1-NOV-2018 09:00:00.00	Ain Deek & Teis Drinking Water Treatment Plant	POST FILT	0.89	<1.0	<1.0
171235	WJ024194	1-NOV-2018 09:10:00.00	Ain Deek & Teis Drinking Water Treatment Plant	POST UV	0.81	<1.0	<1.0
171354	WJ024215	5-NOV-2018 09:30:00.00	Ain Deek & Teis Drinking Water Treatment Plant	FINALPROD	0.78	Absence	Absence
24196.0*				RW	0.97	3448.0*	24196.0*

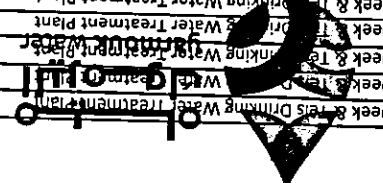

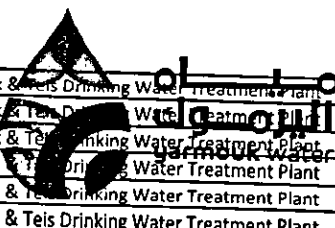

Ref	WJ023542	16-AUG-2018 09:05:00.00	Ain Deek & Teis Drinking Water Treatment Plant	POST_UV	0.82	<1.0	<1.0
167198	WJ023542	16-AUG-2018 09:10:00.00	Ain Deek & Teis Drinking Water Treatment Plant	POST_UV	0.82	<1.0	<1.0
167199	WJ023542	16-AUG-2018 09:15:00.00	Ain Deek & Teis Drinking Water Treatment Plant	POST_UV	0.75	<1.0	<1.0
167200	WJ023542	16-AUG-2018 09:15:00.00	Ain Deek & Teis Drinking Water Treatment Plant	POST_UV	0.75	<1.0	<1.0
167329	WJ023556	19-AUG-2018 08:15:00.00	Ain Deek & Teis Drinking Water Treatment Plant	FINALPROD	0.7	Absence	Absence
167329	WJ023556	19-AUG-2018 08:15:00.00	Ain Deek & Teis Drinking Water Treatment Plant	RW			
167330	WJ023556	19-AUG-2018 08:20:00.00	Ain Deek & Teis Drinking Water Treatment Plant	RW	0.86	5.2	68.3
167330	WJ023556	19-AUG-2018 08:20:00.00	Ain Deek & Teis Drinking Water Treatment Plant	POST_UV			
167331	WJ023556	19-AUG-2018 08:25:00.00	Ain Deek & Teis Drinking Water Treatment Plant	POST_UV	0.8		<1.8
167331	WJ023556	19-AUG-2018 08:25:00.00	Ain Deek & Teis Drinking Water Treatment Plant	POST_UV	0.8		<1.8
167332	WJ023556	19-AUG-2018 08:30:00.00	Ain Deek & Teis Drinking Water Treatment Plant	POST_UV	0.74		
167332	WJ023556	19-AUG-2018 08:30:00.00	Ain Deek & Teis Drinking Water Treatment Plant	POST_UV	0.74		
167332	WJ023556	19-AUG-2018 08:30:00.00	Ain Deek & Teis Drinking Water Treatment Plant	FINALPROD			
167342	WJ023557	23-AUG-2018 08:30:00.00	Ain Deek & Teis Drinking Water Treatment Plant	FINALPROD	0.72		<1.1
167343	WJ023557	23-AUG-2018 08:40:00.00	Ain Deek & Teis Drinking Water Treatment Plant	RW	0.93	10.8	160.7
167349	WJ023558	20-AUG-2018 10:00:00.00	Ain Deek & Teis Drinking Water Treatment Plant	FINALPROD	0.77	Absence	Absence
167350	WJ023558	20-AUG-2018 10:10:00.00	Ain Deek & Teis Drinking Water Treatment Plant	RW	0.93	72.7	365.4
167448	WJ023570	26-AUG-2018 08:20:00.00	Ain Deek & Teis Drinking Water Treatment Plant	FINALPROD	0.74	Absence	Absence
167449	WJ023570	26-AUG-2018 08:25:00.00	Ain Deek & Teis Drinking Water Treatment Plant	RW	0.88	8.5	85.7
167450	WJ023570	26-AUG-2018 08:30:00.00	Ain Deek & Teis Drinking Water Treatment Plant	POST_UV	0.81		<1.8
167451	WJ023570	26-AUG-2018 08:35:00.00	Ain Deek & Teis Drinking Water Treatment Plant	POST_UV	0.77		<1.8
167554	WJ023586	28-AUG-2018 07:55:00.00	Ain Deek & Teis Drinking Water Treatment Plant	FINALPROD	0.71		<1.10
167555	WJ023586	28-AUG-2018 08:00:00.00	Ain Deek & Teis Drinking Water Treatment Plant	RW	0.81	42	131.4
167556	WJ023586	28-AUG-2018 08:05:00.00	Ain Deek & Teis Drinking Water Treatment Plant	POST_UV	0.71		<1.8
167557	WJ023586	28-AUG-2018 08:10:00.00	Ain Deek & Teis Drinking Water Treatment Plant	POST_UV	0.65		<1.8
167655	WJ023601	29-AUG-2018 09:15:00.00	Ain Deek & Teis Drinking Water Treatment Plant	FINALPROD	0.6		<1.10
167656	WJ023601	29-AUG-2018 09:20:00.00	Ain Deek & Teis Drinking Water Treatment Plant	RW	0.88	3.1	54.8
167657	WJ023601	29-AUG-2018 09:25:00.00	Ain Deek & Teis Drinking Water Treatment Plant	POST_UV	0.8		<1.8
167658	WJ023601	29-AUG-2018 09:30:00.00	Ain Deek & Teis Drinking Water Treatment Plant	POST_UV	0.73		<1.8
167839	WJ023635	2-SEP-2018 09:05:00.00	Ain Deek & Teis Drinking Water Treatment Plant	FINALPROD	0.7		<1.10
167840	WJ023635	2-SEP-2018 09:10:00.00	Ain Deek & Teis Drinking Water Treatment Plant	RW	0.83	4.1	60.2
167841	WJ023635	2-SEP-2018 09:15:00.00	Ain Deek & Teis Drinking Water Treatment Plant	POST_UV	0.74		<1.8
167842	WJ023635	2-SEP-2018 09:20:00.00	Ain Deek & Teis Drinking Water Treatment Plant	POST_UV	0.7		<1.8
167995	WJ023662	4-SEP-2018 07:30:00.00	Ain Deek & Teis Drinking Water Treatment Plant	FINALPROD	0.61		<1.10
167996	WJ023662	4-SEP-2018 07:35:00.00	Ain Deek & Teis Drinking Water Treatment Plant	RW	0.89	85.5	248.1
167997	WJ023662	4-SEP-2018 07:40:00.00	Ain Deek & Teis Drinking Water Treatment Plant	POST_UV	0.83		<1.8
167998	WJ023662	4-SEP-2018 07:45:00.00	Ain Deek & Teis Drinking Water Treatment Plant	POST_UV	0.78		<1.8
168147	WJ023693	6-SEP-2018 09:00:00.00	Ain Deek & Teis Drinking Water Treatment Plant	FINALPROD	0.72		<1.10
168148	WJ023693	6-SEP-2018 09:05:00.00	Ain Deek & Teis Drinking Water Treatment Plant	RW	0.87	7.5	71.7
168149	WJ023693	6-SEP-2018 09:10:00.00	Ain Deek & Teis Drinking Water Treatment Plant	POST_UV	0.81	<1.0	<1.0
168150	WJ023693	6-SEP-2018 09:15:00.00	Ain Deek & Teis Drinking Water Treatment Plant	POST_UV	0.73	<1.0	1
168252	WJ023704	9-SEP-2018 08:40:00.00	Ain Deek & Teis Drinking Water Treatment Plant	FINALPROD	0.62	Absence	Absence
168253	WJ023704	9-SEP-2018 08:45:00.00	Ain Deek & Teis Drinking Water Treatment Plant	RW	0.87	3.1	201.4
168254	WJ023704	9-SEP-2018 08:50:00.00	Ain Deek & Teis Drinking Water Treatment Plant	POST_UV	0.81	<1.0	<1.0
168255	WJ023704	9-SEP-2018 09:00:00.00	Ain Deek & Teis Drinking Water Treatment Plant	POST_UV	0.77	<1.0	<1.0
168314	WJ023717	10-SEP-2018 08:35:00.00	Ain Deek & Teis Drinking Water Treatment Plant	FINALPROD	0.73	Absence	Absence
168315	WJ023717	10-SEP-2018 08:40:00.00	Ain Deek & Teis Drinking Water Treatment Plant	RW	0.87	2	72.7
168316	WJ023717	10-SEP-2018 08:45:00.00	Ain Deek & Teis Drinking Water Treatment Plant	POST_UV	0.79	<1.0	<1.0
168317	WJ023717	10-SEP-2018 08:50:00.00	Ain Deek & Teis Drinking Water Treatment Plant	POST_UV	0.71	<1.0	<1.0
168486	WJ023749	13-SEP-2018 09:20:00.00	Ain Deek & Teis Drinking Water Treatment Plant	FINALPROD	0.64	Absence	Absence
168487	WJ023749	13-SEP-2018 09:25:00.00	Ain Deek & Teis Drinking Water Treatment Plant	RW		2	51.2
168489	WJ023749	13-SEP-2018 09:30:00.00	Ain Deek & Teis Drinking Water Treatment Plant	POST_UV		<1.0	<1.0
168490	WJ023749	13-SEP-2018 09:35:00.00	Ain Deek & Teis Drinking Water Treatment Plant	POST_UV		<1.0	<1.0
168572	WJ023763	16-SEP-2018 08:30:00.00	Ain Deek & Teis Drinking Water Treatment Plant	FINALPROD		Absence	Absence
168573	WJ023763	16-SEP-2018 08:35:00.00	Ain Deek & Teis Drinking Water Treatment Plant	RW	0.98	<1.0	57.3
168574	WJ023763	16-SEP-2018 08:40:00.00	Ain Deek & Teis Drinking Water Treatment Plant	POST_UV	0.9	<1.0	<1.0
168575	WJ023763	16-SEP-2018 08:45:00.00	Ain Deek & Teis Drinking Water Treatment Plant	POST_UV	0.83	<1.0	<1.0
168740	WJ023793	18-SEP-2018 09:40:00.00	Ain Deek & Teis Drinking Water Treatment Plant	FINALPROD	0.79	Absence	Absence
168742	WJ023793	18-SEP-2018 09:50:00.00	Ain Deek & Teis Drinking Water Treatment Plant	RW	0.93	1	112.4
168743	WJ023793	18-SEP-2018 10:00:00.00	Ain Deek & Teis Drinking Water Treatment Plant	POST_UV	0.85	<1.0	<1.0
168744	WJ023793	18-SEP-2018 10:10:00.00	Ain Deek & Teis Drinking Water Treatment Plant	POST_UV	0.77	<1.0	<1.0
168921	WJ023817	20-SEP-2018 08:30:00.00	Ain Deek & Teis Drinking Water Treatment Plant	FINALPROD	0.72	Absence	Absence
168922	WJ023817	20-SEP-2018 08:35:00.00	Ain Deek & Teis Drinking Water Treatment Plant	RW	0.91	<1.0	67
168923	WJ023817	20-SEP-2018 08:40:00.00	Ain Deek & Teis Drinking Water Treatment Plant	POST_UV	0.85	<1.0	<1.0
168924	WJ023817	20-SEP-2018 08:45:00.00	Ain Deek & Teis Drinking Water Treatment Plant	POST_UV	0.77	<1.0	<1.0
169102	WJ023840	24-SEP-2018 08:35:00.00	Ain Deek & Teis Drinking Water Treatment Plant	FINALPROD	0.7	Absence	Absence
169103	WJ023840	24-SEP-2018 08:40:00.00	Ain Deek & Teis Drinking Water Treatment Plant	RW	0.93	4.1	87.8
169104	WJ023840	24-SEP-2018 08:45:00.00	Ain Deek & Teis Drinking Water Treatment Plant	POST_UV	0.82	<1.0	<1.0
169105	WJ023840	24-SEP-2018 08:50:00.00	Ain Deek & Teis Drinking Water Treatment Plant	POST_UV	0.77	<1.0	2
169198	WJ023852	25-SEP-2018 10:30:00.00	Ain Deek & Teis Drinking Water Treatment Plant	FINALPROD	0.72	Absence	Absence
				RW	0.9	5.2	68.3

Yarmouk Water Company
 Irbid, Baghdad St. P.O.Box 378,Irbid 21110 Jordan
 Tel: +962 2 727 5477 Fax:+962 2 727 0707
 Website :- www.yw.com.jo Email : Info@yw.com.jo

شركة مياه اليرموك
 اربد، شارع بغداد ص. ب. 378 اربد 21110 الاردن
 هاتف :- +96227275477 فاكس :- +96227270707
 الموقع الالكتروني :- www.yw.com.jo البريد الالكتروني :- Info@yw.com.jo

171355	WJ024215	5-NOV-2018 09:35:00.00	Ain Deek & Teis Drinking Water Treatment Plant	POST_UV	0.89	<1.0	<1.0
171356	WJ024215	5-NOV-2018 09:40:00.00	Ain Deek & Teis Drinking Water Treatment Plant	POST_FILTER	0.81	<1.0	<1.0
171357	WJ024215	5-NOV-2018 09:45:00.00	Ain Deek & Teis Drinking Water Treatment Plant	FINALPROD	0.77	Absence	Absence
171440	WJ024230	6-NOV-2018 09:00:00.00	Ain Deek & Teis Drinking Water Treatment Plant	RW	0.99	2419.6*	>2419.6*
171441	WJ024230	6-NOV-2018 09:05:00.00	Ain Deek & Teis Drinking Water Treatment Plant	POST_UV	0.91	<1.0	<1.0
171442	WJ024230	6-NOV-2018 09:10:00.00	Ain Deek & Teis Drinking Water Treatment Plant	POST_FILTER	0.87	<1.0	1
171443	WJ024230	6-NOV-2018 09:15:00.00	Ain Deek & Teis Drinking Water Treatment Plant	FINALPROD	0.85	Absence	Absence
171607	WJ024258	8-NOV-2018 09:05:00.00	Ain Deek & Teis Drinking Water Treatment Plant	RW	0.88	727	>2419.6
171608	WJ024258	8-NOV-2018 09:10:00.00	Ain Deek & Teis Drinking Water Treatment Plant	POST_UV	0.81	<1.0	<1.0
171609	WJ024258	8-NOV-2018 09:15:00.00	Ain Deek & Teis Drinking Water Treatment Plant	POST_FILTER	0.78	<1.0	<1.0
171610	WJ024258	8-NOV-2018 09:20:00.00	Ain Deek & Teis Drinking Water Treatment Plant	FINALPROD	0.75	Absence	Absence
171654	WJ024270	11-NOV-2018 09:10:00.00	Ain Deek & Teis Drinking Water Treatment Plant	RW	1.05	272.3	2419.6
171655	WJ024270	11-NOV-2018 09:15:00.00	Ain Deek & Teis Drinking Water Treatment Plant	POST_UV	0.94	<1.0	<1.0
171656	WJ024270	11-NOV-2018 09:20:00.00	Ain Deek & Teis Drinking Water Treatment Plant	POST_FILTER	0.87	<1.0	<1.0
171657	WJ024270	11-NOV-2018 09:25:00.00	Ain Deek & Teis Drinking Water Treatment Plant	FINALPROD	0.82	Absence	Absence
171797	WJ024297	13-NOV-2018 09:25:00.00	Ain Deek & Teis Drinking Water Treatment Plant	RW	0.98	90.6	866.4
171798	WJ024297	13-NOV-2018 09:30:00.00	Ain Deek & Teis Drinking Water Treatment Plant	POST_UV	0.91	<1.0	<1.0
171799	WJ024297	13-NOV-2018 09:35:00.00	Ain Deek & Teis Drinking Water Treatment Plant	POST_FILTER	0.85	<1.0	<1.0
171800	WJ024297	13-NOV-2018 09:40:00.00	Ain Deek & Teis Drinking Water Treatment Plant	FINALPROD	0.81	Absence	Absence
171934	WJ024321	15-NOV-2018 08:30:00.00	Ain Deek & Teis Drinking Water Treatment Plant	RW	1.1	152.9	>2419.6
171935	WJ024321	15-NOV-2018 08:35:00.00	Ain Deek & Teis Drinking Water Treatment Plant	POST_UV	0.95	<1.0	1
171936	WJ024321	15-NOV-2018 08:40:00.00	Ain Deek & Teis Drinking Water Treatment Plant	POST_FILTER	0.9	<1.0	<1.0
171937	WJ024321	15-NOV-2018 08:45:00.00	Ain Deek & Teis Drinking Water Treatment Plant	FINALPROD	0.88	Absence	Absence
172037	WJ024334	18-NOV-2018 08:15:00.00	Ain Deek & Teis Drinking Water Treatment Plant	RW	1.15	248.9	1986.3
172038	WJ024334	18-NOV-2018 08:20:00.00	Ain Deek & Teis Drinking Water Treatment Plant	POST_UV	0.97	<1.0	<1.0
172040	WJ024334	18-NOV-2018 08:25:00.00	Ain Deek & Teis Drinking Water Treatment Plant	POST_FILTER	0.89	<1.0	<1.0
172041	WJ024334	18-NOV-2018 08:30:00.00	Ain Deek & Teis Drinking Water Treatment Plant	FINALPROD	0.81	Absence	Absence
172174	WJ024358	21-NOV-2018 08:20:00.00	Ain Deek & Teis Drinking Water Treatment Plant	RW	0.97	48.9	378.4
172175	WJ024358	21-NOV-2018 08:25:00.00	Ain Deek & Teis Drinking Water Treatment Plant	POST_UV	0.91	<1.0	1
172176	WJ024358	21-NOV-2018 08:30:00.00	Ain Deek & Teis Drinking Water Treatment Plant	POST_FILTER	0.85	<1.0	<1.0
172177	WJ024358	21-NOV-2018 08:35:00.00	Ain Deek & Teis Drinking Water Treatment Plant	FINALPROD	0.8	Absence	Absence
172282	WJ024372	22-NOV-2018 09:15:00.00	Ain Deek & Teis Drinking Water Treatment Plant	RW	1.1	47.1	435.2
172283	WJ024372	22-NOV-2018 09:20:00.00	Ain Deek & Teis Drinking Water Treatment Plant	POST_UV	1.01	<1.0	1
172284	WJ024372	22-NOV-2018 09:25:00.00	Ain Deek & Teis Drinking Water Treatment Plant	POST_FILTER	0.93	<1.0	<1.0
172286	WJ024372	22-NOV-2018 09:30:00.00	Ain Deek & Teis Drinking Water Treatment Plant	FINALPROD	0.87	Absence	Absence
172338	WJ024383	25-NOV-2018 08:30:00.00	Ain Deek & Teis Drinking Water Treatment Plant	RW	1.17	30.9	275.5
172339	WJ024383	25-NOV-2018 08:35:00.00	Ain Deek & Teis Drinking Water Treatment Plant	POST_UV	0.97	<1.0	<1.0
172340	WJ024383	25-NOV-2018 08:40:00.00	Ain Deek & Teis Drinking Water Treatment Plant	POST_FILTER	0.9	<1.0	<1.0
172341	WJ024383	25-NOV-2018 08:45:00.00	Ain Deek & Teis Drinking Water Treatment Plant	FINALPROD	0.87	Absence	Absence
172441	WJ024401	27-NOV-2018 09:20:00.00	Ain Deek & Teis Drinking Water Treatment Plant	RW	1.11	14.6	187.2
172442	WJ024401	27-NOV-2018 09:25:00.00	Ain Deek & Teis Drinking Water Treatment Plant	POST_UV	0.97	<1.0	<1.0
172443	WJ024401	27-NOV-2018 09:30:00.00	Ain Deek & Teis Drinking Water Treatment Plant	POST_FILTER	0.89	<1.0	<1.0
172444	WJ024401	27-NOV-2018 09:35:00.00	Ain Deek & Teis Drinking Water Treatment Plant	FINALPROD	0.85	Absence	Absence
172626	WJ024431	29-NOV-2018 08:25:00.00	Ain Deek & Teis Drinking Water Treatment Plant	RW	1.13	12.1	123.6
172627	WJ024431	29-NOV-2018 08:30:00.00	Ain Deek & Teis Drinking Water Treatment Plant	POST_UV	1.02	<1.0	<1.0
172628	WJ024431	29-NOV-2018 08:35:00.00	Ain Deek & Teis Drinking Water Treatment Plant	POST_FILTER	0.96	<1.0	<1.0
172629	WJ024431	29-NOV-2018 08:40:00.00	Ain Deek & Teis Drinking Water Treatment Plant	FINALPROD	0.85	Absence	Absence
172645	WJ024435	2-DEC-2018 10:00:00.00	Ain Deek & Teis Drinking Water Treatment Plant	RW	0.99	108.6	435.2
172646	WJ024435	2-DEC-2018 10:10:00.00	Ain Deek & Teis Drinking Water Treatment Plant	POST_UV	0.91	<1.0	<1.0
172647	WJ024435	2-DEC-2018 10:15:00.00	Ain Deek & Teis Drinking Water Treatment Plant	POST_FILTER	0.87	<1.0	4.1
172648	WJ024435	2-DEC-2018 10:20:00.00	Ain Deek & Teis Drinking Water Treatment Plant	FINALPROD	0.82	Absence	Absence
172801	WJ024458	4-DEC-2018 09:10:00.00	Ain Deek & Teis Drinking Water Treatment Plant	RW	0.97	11.9	156.5
172802	WJ024458	4-DEC-2018 09:15:00.00	Ain Deek & Teis Drinking Water Treatment Plant	POST_UV	0.91	<1.0	<1.0
172803	WJ024458	4-DEC-2018 09:20:00.00	Ain Deek & Teis Drinking Water Treatment Plant	POST_FILTER	0.87	63.1	816.4
172804	WJ024458	4-DEC-2018 09:25:00.00	Ain Deek & Teis Drinking Water Treatment Plant	FINALPROD	0.83	Absence	Absence
172946	WJ024491	6-DEC-2018 09:35:00.00	Ain Deek & Teis Drinking Water Treatment Plant	RW	0.98	13.4	95.9
172947	WJ024491	6-DEC-2018 09:40:00.00	Ain Deek & Teis Drinking Water Treatment Plant	POST_UV	0.93	<1.0	<1.0
172948	WJ024491	6-DEC-2018 09:45:00.00	Ain Deek & Teis Drinking Water Treatment Plant	POST_FILTER	0.87	<1.0	<1.0
172949	WJ024491	6-DEC-2018 09:50:00.00	Ain Deek & Teis Drinking Water Treatment Plant	FINALPROD	0.8	Absence	Absence
173014	WJ024503	9-DEC-2018 09:15:00.00	Ain Deek & Teis Drinking Water Treatment Plant	RW	1.25	387.7	>2419.6
173015	WJ024503	9-DEC-2018 09:20:00.00	Ain Deek & Teis Drinking Water Treatment Plant	POST_UV	1.17	<1.0	1
173016	WJ024503	9-DEC-2018 09:25:00.00	Ain Deek & Teis Drinking Water Treatment Plant	POST_FILTER	1.03	<1.0	15.8
173017	WJ024503	9-DEC-2018 09:30:00.00	Ain Deek & Teis Drinking Water Treatment Plant	FINALPROD	0.99	Absence	Absence
173102	WJ024522	11-DEC-2018 10:50:00.00	Ain Deek & Teis Drinking Water Treatment Plant	RW	1.1	36.9	410.6
173103	WJ024522	11-DEC-2018 10:55:00.00	Ain Deek & Teis Drinking Water Treatment Plant	POST_UV	0.97	<1.0	<1.0
173104	WJ024522	11-DEC-2018 11:00:00.00	Ain Deek & Teis Drinking Water Treatment Plant	POST_FILTER	0.94	<1.0	<1.0
173105	WJ024522	11-DEC-2018 11:05:00.00	Ain Deek & Teis Drinking Water Treatment Plant	FINALPROD	0.88	Absence	Absence
173245	WJ024548	13-DEC-2018 09:00:00.00	Ain Deek & Teis Drinking Water Treatment Plant	RW	1.13	23.1	307.6

173246	WJ024548	13-DEC-2018 09:05:00.00	Ain Deek & Teis Drinking Water Treatment Plant	POST_UV	1.04	<1.0	<1.0
173247	WJ024548	13-DEC-2018 09:10:00.00	Ain Deek & Teis Drinking Water Treatment Plant	POST_FILT	0.97	<1.0	<1.0
173248	WJ024548	13-DEC-2018 09:15:00.00	Ain Deek & Teis Drinking Water Treatment Plant	FINALPROD	0.91	Absence	Absence
173358	WJ024564	16-DEC-2018 10:40:00.00	Ain Deek & Teis Drinking Water Treatment Plant	RW	0.94	17.3	488.4
173359	WJ024564	16-DEC-2018 10:45:00.00	Ain Deek & Teis Drinking Water Treatment Plant	POST_UV	0.89	<1.0	<1.0
173360	WJ024564	16-DEC-2018 10:50:00.00	Ain Deek & Teis Drinking Water Treatment Plant	POST_FILT	0.83	<1.0	<1.0
173361	WJ024564	16-DEC-2018 10:55:00.00	Ain Deek & Teis Drinking Water Treatment Plant	FINALPROD	0.79	Absence	Absence
173500	WJ024587	19-DEC-2018 08:30:00.00	Ain Deek & Teis Drinking Water Treatment Plant	RW	0.97	29.2	517.2
173501	WJ024587	19-DEC-2018 08:35:00.00	Ain Deek & Teis Drinking Water Treatment Plant	POST_UV	0.89	<1.0	<1.0
173502	WJ024587	19-DEC-2018 08:40:00.00	Ain Deek & Teis Drinking Water Treatment Plant	POST_FILT	0.84	<1.0	1
173503	WJ024587	19-DEC-2018 08:45:00.00	Ain Deek & Teis Drinking Water Treatment Plant	FINALPROD	0.79	Absence	Absence
173630	WJ024609	23-DEC-2018 09:05:00.00	Ain Deek & Teis Drinking Water Treatment Plant	RW	0.96	307.6	2419.6
173631	WJ024609	23-DEC-2018 09:10:00.00	Ain Deek & Teis Drinking Water Treatment Plant	POST_UV	0.91	<1.0	<1.0
173632	WJ024609	23-DEC-2018 09:15:00.00	Ain Deek & Teis Drinking Water Treatment Plant	POST_FILT	0.87	<1.0	1
173633	WJ024609	23-DEC-2018 09:20:00.00	Ain Deek & Teis Drinking Water Treatment Plant	FINALPROD	0.84	Absence	Absence
173830	WJ024648	27-DEC-2018 10:15:00.00	Ain Deek & Teis Drinking Water Treatment Plant	RW	0.99	128.1	>2419.6
173831	WJ024648	27-DEC-2018 10:20:00.00	Ain Deek & Teis Drinking Water Treatment Plant	POST_UV	0.95	<1.0	<1.0
173832	WJ024648	27-DEC-2018 10:25:00.00	Ain Deek & Teis Drinking Water Treatment Plant	POST_FILT	0.89	<1.0	<1.0
173833	WJ024648	27-DEC-2018 10:30:00.00	Ain Deek & Teis Drinking Water Treatment Plant	FINALPROD	0.65	Absence	Absence
173849	WJ024652	30-DEC-2018 09:00:00.00	Ain Deek & Teis Drinking Water Treatment Plant	RW	1.75	2419.6	>2419.6
173850	WJ024652	30-DEC-2018 09:05:00.00	Ain Deek & Teis Drinking Water Treatment Plant	POST_UV	1.25	<1.0	<1.0
173851	WJ024652	30-DEC-2018 09:10:00.00	Ain Deek & Teis Drinking Water Treatment Plant	POST_FILT	1.07	1	7.3
173852	WJ024652	30-DEC-2018 09:15:00.00	Ain Deek & Teis Drinking Water Treatment Plant	FINALPROD	0.98	Absence	Absence
174009	WJ024675	3-JAN-2019 08:40:00.00	Ain Deek & Teis Drinking Water Treatment Plant	RW	1.21	8.5	155.3
174010	WJ024675	3-JAN-2019 08:45:00.00	Ain Deek & Teis Drinking Water Treatment Plant	POST_UV	1.02	<1.0	1
174011	WJ024675	3-JAN-2019 08:50:00.00	Ain Deek & Teis Drinking Water Treatment Plant	POST_FILT	0.97	<1.0	1
174012	WJ024675	3-JAN-2019 08:55:00.00	Ain Deek & Teis Drinking Water Treatment Plant	FINALPROD	0.92	Absence	Absence
174064	WJ024687	6-JAN-2019 08:00:00.00	Ain Deek & Teis Drinking Water Treatment Plant	RW	1.09	10.5	68.9
174065	WJ024687	6-JAN-2019 08:05:00.00	Ain Deek & Teis Drinking Water Treatment Plant	POST_UV	0.97	<1.0	<1.0
174066	WJ024687	6-JAN-2019 08:10:00.00	Ain Deek & Teis Drinking Water Treatment Plant	POST_FILT	0.91	<1.0	<1.0
174067	WJ024687	6-JAN-2019 08:15:00.00	Ain Deek & Teis Drinking Water Treatment Plant	FINALPROD	0.84	Absence	Absence
174174	WJ024706	8-JAN-2019 08:10:00.00	Ain Deek & Teis Drinking Water Treatment Plant	RW	1.25	218.7	1732.9
174175	WJ024706	8-JAN-2019 08:15:00.00	Ain Deek & Teis Drinking Water Treatment Plant	POST_UV	1.17	<1.0	<1.0
174176	WJ024706	8-JAN-2019 08:20:00.00	Ain Deek & Teis Drinking Water Treatment Plant	POST_FILT	0.98	<1.0	1
174177	WJ024706	8-JAN-2019 08:25:00.00	Ain Deek & Teis Drinking Water Treatment Plant	FINALPROD	0.93	Absence	Absence
174254	WJ024719	10-JAN-2019 07:10:00.00	Ain Deek & Teis Drinking Water Treatment Plant	RW	1.35	275.5	2419.6
174255	WJ024719	10-JAN-2019 07:15:00.00	Ain Deek & Teis Drinking Water Treatment Plant	POST_UV	1.17	<1.0	1
174256	WJ024719	10-JAN-2019 07:20:00.00	Ain Deek & Teis Drinking Water Treatment Plant	POST_FILT	1.03	<1.0	1
174257	WJ024719	10-JAN-2019 07:25:00.00	Ain Deek & Teis Drinking Water Treatment Plant	FINALPROD	0.97	Absence	Absence
174325	WJ024728	13-JAN-2019 10:10:00.00	Ain Deek & Teis Drinking Water Treatment Plant	RW	2.02	193.5	1299.7
174326	WJ024728	13-JAN-2019 10:15:00.00	Ain Deek & Teis Drinking Water Treatment Plant	POST_UV	1.95	<1.0	<1.0
174327	WJ024728	13-JAN-2019 10:20:00.00	Ain Deek & Teis Drinking Water Treatment Plant	POST_FILT	1.15	<1.0	<1.0
174328	WJ024728	13-JAN-2019 10:25:00.00	Ain Deek & Teis Drinking Water Treatment Plant	FINALPROD	1.03	Absence	Absence
174399	WJ024738	15-JAN-2019 07:45:00.00	Ain Deek & Teis Drinking Water Treatment Plant	RW	1.33	27.5	325.5
174400	WJ024738	15-JAN-2019 07:50:00.00	Ain Deek & Teis Drinking Water Treatment Plant	POST_UV	1.15	<1.0	<1.0
174401	WJ024738	15-JAN-2019 07:55:00.00	Ain Deek & Teis Drinking Water Treatment Plant	POST_FILT	0.97	<1.0	<1.0
174402	WJ024738	15-JAN-2019 08:00:00.00	Ain Deek & Teis Drinking Water Treatment Plant	FINALPROD	0.95	Absence	Absence
174564	WJ024777	20-JAN-2019 07:30:00.00	Ain Deek & Teis Drinking Water Treatment Plant	RW	2.88	40.8	365.4
174565	WJ024777	20-JAN-2019 07:35:00.00	Ain Deek & Teis Drinking Water Treatment Plant	POST_FILT	1.9	<1.0	<1.0
174566	WJ024777	20-JAN-2019 07:40:00.00	Ain Deek & Teis Drinking Water Treatment Plant	POST_UV	1.73	<1.0	1
174567	WJ024777	20-JAN-2019 07:45:00.00	Ain Deek & Teis Drinking Water Treatment Plant	FINALPROD	1.22	Absence	Absence
174712	WJ024806	22-JAN-2019 07:30:00.00	Ain Deek & Teis Drinking Water Treatment Plant	RW	2.74	21.3	344.8
174713	WJ024806	22-JAN-2019 07:40:00.00	Ain Deek & Teis Drinking Water Treatment Plant	POST_UV	1.87	<1.0	<1.0
174714	WJ024806	22-JAN-2019 07:45:00.00	Ain Deek & Teis Drinking Water Treatment Plant	POST_FILT	1.74	<1.0	1
174715	WJ024806	22-JAN-2019 08:00:00.00	Ain Deek & Teis Drinking Water Treatment Plant	FINALPROD	1.33	Absence	Absence
174854	WJ024834	24-JAN-2019 08:15:00.00	Ain Deek & Teis Drinking Water Treatment Plant	RW	2.77	1	24.6
174855	WJ024834	24-JAN-2019 08:20:00.00	Ain Deek & Teis Drinking Water Treatment Plant	POST_FILT	1.95	<1.0	<1.0
174856	WJ024834	24-JAN-2019 08:25:00.00	Ain Deek & Teis Drinking Water Treatment Plant	POST_UV	1.77	<1.0	<1.0
174857	WJ024834	24-JAN-2019 08:30:00.00	Ain Deek & Teis Drinking Water Treatment Plant	FINALPROD	1.32	Absence	Absence
174890	WJ024840	27-JAN-2019 08:00:00.00	Ain Deek & Teis Drinking Water Treatment Plant	RW	2.77	15.5	272.3
174891	WJ024840	27-JAN-2019 08:10:00.00	Ain Deek & Teis Drinking Water Treatment Plant	POST_UV	1.88	<1.0	<1.0
174892	WJ024840	27-JAN-2019 08:15:00.00	Ain Deek & Teis Drinking Water Treatment Plant	POST_FILT	1.72	<1.0	<1.0
174893	WJ024840	27-JAN-2019 08:20:00.00	Ain Deek & Teis Drinking Water Treatment Plant	FINALPROD	1.33	Absence	Absence
175026	WJ024865	29-JAN-2019 08:00:00.00	Ain Deek & Teis Drinking Water Treatment Plant	RW	2.02	34.1	461.1
175027	WJ024865	29-JAN-2019 08:05:00.00	Ain Deek & Teis Drinking Water Treatment Plant	POST_UV	1.98	<1.0	<1.0
175028	WJ024865	29-JAN-2019 08:10:00.00	Ain Deek & Teis Drinking Water Treatment Plant	POST_FILT	0.78	<1.0	<1.0
175029	WJ024865	29-JAN-2019 08:15:00.00	Ain Deek & Teis Drinking Water Treatment Plant	FINALPROD	0.85	Absence	Absence
175146	WJ024884	31-JAN-2019 09:15:00.00	Ain Deek & Teis Drinking Water Treatment Plant	RW	2.27	8.5	83.9

175147	WJ024884	31-JAN-2019 09:20:00.00	Ain Deek & Teis Drinking Water Treatment Plant	POST UV	1.9	<1.0	<1.0
175148	WJ024884	31-JAN-2019 09:30:00.00	Ain Deek & Teis Drinking Water Treatment Plant	POST_FILT	1.73	<1.0	<1.0
175149	WJ024884	31-JAN-2019 09:45:00.00	Ain Deek & Teis Drinking Water Treatment Plant	FINALPROD	1.23	<1	<1
175182	WJ024887	3-FEB-2019 08:00:00.00	Ain Deek & Teis Drinking Water Treatment Plant	RW	0.98	6.3	67.6
175183	WJ024887	3-FEB-2019 08:10:00.00	Ain Deek & Teis Drinking Water Treatment Plant	POST UV	2.66	<1.0	<1.0
175184	WJ024887	3-FEB-2019 08:15:00.00	Ain Deek & Teis Drinking Water Treatment Plant	POST_FILT	1.87	<1.0	<1.0
175185	WJ024887	3-FEB-2019 08:20:00.00	Ain Deek & Teis Drinking Water Treatment Plant	FINALPROD	1.71	Absence	Absence
175313	WJ024913	5-FEB-2019 08:00:00.00	Ain Deek & Teis Drinking Water Treatment Plant	RW	2.66	11	123.6
175314	WJ024913	5-FEB-2019 08:05:00.00	Ain Deek & Teis Drinking Water Treatment Plant	POST UV	1.87	<1.0	<1.0
175315	WJ024913	5-FEB-2019 08:10:00.00	Ain Deek & Teis Drinking Water Treatment Plant	POST_FILT	1.71	<1.0	<1.0
175316	WJ024913	5-FEB-2019 08:15:00.00	Ain Deek & Teis Drinking Water Treatment Plant	FINALPROD	1.34	Absence	Absence
175433	WJ024935	7-FEB-2019 08:00:00.00	Ain Deek & Teis Drinking Water Treatment Plant	RW		4.1	65.7
175435	WJ024935	7-FEB-2019 08:05:00.00	Ain Deek & Teis Drinking Water Treatment Plant	POST UV		<1.0	<1.0
175437	WJ024935	7-FEB-2019 08:10:00.00	Ain Deek & Teis Drinking Water Treatment Plant	POST_FILT		<1.0	<1.0
175440	WJ024935	7-FEB-2019 08:15:00.00	Ain Deek & Teis Drinking Water Treatment Plant	FINALPROD		Absence	Absence
175532	WJ024954	10-FEB-2019 07:30:00.00	Ain Deek & Teis Drinking Water Treatment Plant	RW	1.66	67	1046.2
175533	WJ024954	10-FEB-2019 07:35:00.00	Ain Deek & Teis Drinking Water Treatment Plant	POST UV	1.6	<1.0	<1.0
175534	WJ024954	10-FEB-2019 07:40:00.00	Ain Deek & Teis Drinking Water Treatment Plant	POST_FILT	1	<1.0	<1.0
175535	WJ024954	10-FEB-2019 07:45:00.00	Ain Deek & Teis Drinking Water Treatment Plant	FINALPROD	1.34	Absence	Absence
175664	WJ024986	12-FEB-2019 07:30:00.00	Ain Deek & Teis Drinking Water Treatment Plant	RW		43.2	365.4
175665	WJ024986	12-FEB-2019 07:35:00.00	Ain Deek & Teis Drinking Water Treatment Plant	POST UV		<1.0	<1.0
175666	WJ024986	12-FEB-2019 07:40:00.00	Ain Deek & Teis Drinking Water Treatment Plant	POST_FILT		<1.0	1
175667	WJ024986	12-FEB-2019 07:45:00.00	Ain Deek & Teis Drinking Water Treatment Plant	FINALPROD		Absence	Absence
175765	WJ025009	14-FEB-2019 07:30:00.00	Ain Deek & Teis Drinking Water Treatment Plant	RW	2.44	6.3	133.4
175766	WJ025009	14-FEB-2019 07:40:00.00	Ain Deek & Teis Drinking Water Treatment Plant	POST UV	1.66	<1.0	<1.0
175767	WJ025009	14-FEB-2019 07:50:00.00	Ain Deek & Teis Drinking Water Treatment Plant	POST_FILT	1.51	<1.0	<1.0
175768	WJ025009	14-FEB-2019 08:00:00.00	Ain Deek & Teis Drinking Water Treatment Plant	FINALPROD	1.02	Absence	Absence
175842	WJ025020	17-FEB-2019 09:45:00.00	Ain Deek & Teis Drinking Water Treatment Plant	RW	1.19	14.5	150
175843	WJ025020	17-FEB-2019 09:50:00.00	Ain Deek & Teis Drinking Water Treatment Plant	POST UV	1.02	<1.0	<1.0
175844	WJ025020	17-FEB-2019 09:55:00.00	Ain Deek & Teis Drinking Water Treatment Plant	POST_FILT	0.97	<1.0	1
175845	WJ025020	17-FEB-2019 10:00:00.00	Ain Deek & Teis Drinking Water Treatment Plant	FINALPROD	0.9	Absence	Absence
176032	WJ025051	19-FEB-2019 08:30:00.00	Ain Deek & Teis Drinking Water Treatment Plant	RW	2.25	27.5	488.4
176033	WJ025051	19-FEB-2019 08:40:00.00	Ain Deek & Teis Drinking Water Treatment Plant	POST UV	2.11	<1.0	<1.0
176034	WJ025051	19-FEB-2019 08:50:00.00	Ain Deek & Teis Drinking Water Treatment Plant	POST_FILT	1.66	<1.0	<1.0
176035	WJ025051	19-FEB-2019 09:00:00.00	Ain Deek & Teis Drinking Water Treatment Plant	FINALPROD	1.5	Absence	Absence
176105	WJ025061	21-FEB-2019 08:00:00.00	Ain Deek & Teis Drinking Water Treatment Plant	RW	2.02	28.8	816.4
176106	WJ025061	21-FEB-2019 08:05:00.00	Ain Deek & Teis Drinking Water Treatment Plant	POST UV	1.94	<1.0	<1.0
176107	WJ025061	21-FEB-2019 08:10:00.00	Ain Deek & Teis Drinking Water Treatment Plant	POST_FILT	1.04	<1.0	<1.0
176108	WJ025061	21-FEB-2019 08:20:00.00	Ain Deek & Teis Drinking Water Treatment Plant	FINALPROD	1.04	Absence	Absence
176180	WJ025075	24-FEB-2019 08:40:00.00	Ain Deek & Teis Drinking Water Treatment Plant	RW	1.41	5.2	159.7
176181	WJ025075	24-FEB-2019 08:50:00.00	Ain Deek & Teis Drinking Water Treatment Plant	POST UV	1.34	<1.0	<1.0
176182	WJ025075	24-FEB-2019 09:00:00.00	Ain Deek & Teis Drinking Water Treatment Plant	POST_FILT	1.01	<1.0	1
176183	WJ025075	24-FEB-2019 09:10:00.00	Ain Deek & Teis Drinking Water Treatment Plant	FINALPROD	1.04	Absence	Absence
176275	WJ025091	26-FEB-2019 08:30:00.00	Ain Deek & Teis Drinking Water Treatment Plant	RW	0.62	9.7	90.9
176276	WJ025091	26-FEB-2019 08:40:00.00	Ain Deek & Teis Drinking Water Treatment Plant	POST UV	0.6	<1.0	<1.0
176277	WJ025091	26-FEB-2019 08:50:00.00	Ain Deek & Teis Drinking Water Treatment Plant	POST_FILT	0.55	<1.0	<1.0
176278	WJ025091	26-FEB-2019 09:00:00.00	Ain Deek & Teis Drinking Water Treatment Plant	FINALPROD	0.81	Absence	Absence
176611	WJ025163	7-MAR-2019 09:00:00.00	Ain Deek & Teis Drinking Water Treatment Plant	RW	2.35	20.3	187.2
176613	WJ025163	7-MAR-2019 09:05:00.00	Ain Deek & Teis Drinking Water Treatment Plant	POST UV	1.97	<1.0	<1.0
176614	WJ025163	7-MAR-2019 09:10:00.00	Ain Deek & Teis Drinking Water Treatment Plant	POST_FILT	1.9	<1.0	1
176679	WJ025163	7-MAR-2019 09:15:00.00	Ain Deek & Teis Drinking Water Treatment Plant	FINALPROD	1.88	Absence	Absence
176686	WJ025184	10-MAR-2019 08:15:00.00	Ain Deek & Teis Drinking Water Treatment Plant	RW	1.98	19.7	222.4
176687	WJ025184	10-MAR-2019 08:20:00.00	Ain Deek & Teis Drinking Water Treatment Plant	POST UV	1.83	<1.0	<1.0
176689	WJ025184	10-MAR-2019 08:25:00.00	Ain Deek & Teis Drinking Water Treatment Plant	POST_FILT	1.79	<1.0	<1.0
176690	WJ025184	10-MAR-2019 08:30:00.00	Ain Deek & Teis Drinking Water Treatment Plant	FINALPROD	1.66	Absence	Absence
176837	WJ025208	12-MAR-2019 07:30:00.00	Ain Deek & Teis Drinking Water Treatment Plant	RW	2.66	21.6	214.3
176891	WJ025208	12-MAR-2019 07:35:00.00	Ain Deek & Teis Drinking Water Treatment Plant	POST UV	1.87	<1.0	1
176892	WJ025208	12-MAR-2019 07:40:00.00	Ain Deek & Teis Drinking Water Treatment Plant	POST_FILT	1.71	<1.0	<1.0
176893	WJ025208	12-MAR-2019 07:50:00.00	Ain Deek & Teis Drinking Water Treatment Plant	FINALPROD	1.34	Absence	Absence
176944	WJ025232	14-MAR-2019 09:00:00.00	Ain Deek & Teis Drinking Water Treatment Plant	RW	2.15	6.3	86.5
176945	WJ025232	14-MAR-2019 09:10:00.00	Ain Deek & Teis Drinking Water Treatment Plant	POST UV	1.87	<1.0	<1.0
176946	WJ025232	14-MAR-2019 09:15:00.00	Ain Deek & Teis Drinking Water Treatment Plant	POST_FILT	1.71	<1.0	<1.0
176947	WJ025232	14-MAR-2019 09:20:00.00	Ain Deek & Teis Drinking Water Treatment Plant	FINALPROD	1.34	Absence	Absence
177047	WJ025247	17-MAR-2019 09:15:00.00	Ain Deek & Teis Drinking Water Treatment Plant	RW	2.66	7.5	67
177051	WJ025247	17-MAR-2019 09:20:00.00	Ain Deek & Teis Drinking Water Treatment Plant	POST UV	2.5	<1.0	<1.0
177052	WJ025247	17-MAR-2019 09:25:00.00	Ain Deek & Teis Drinking Water Treatment Plant	POST_FILT	1.16	<1.0	3.1
177053	WJ025247	17-MAR-2019 09:30:00.00	Ain Deek & Teis Drinking Water Treatment Plant	FINALPROD	1.1	Absence	Absence
177166	WJ025268	19-MAR-2019 08:00:00.00	Ain Deek & Teis Drinking Water Treatment Plant	RW	1.88	17.1	344.1

177167	WJ025268	19-MAR-2019 08:05:00.00	Ain Deek & Teis Drinking Water Treatment Plant	POST_UV	1.8	<1.0	<1.0
177168	WJ025268	19-MAR-2019 08:10:00.00	Ain Deek & Teis Drinking Water Treatment Plant	POST_FILT	1.12	<1.0	1
177170	WJ025268	19-MAR-2019 08:15:00.00	Ain Deek & Teis Drinking Water Treatment Plant	FINALPROD	1.12	Absence	Absence
177284	WJ025291	21-MAR-2019 08:00:00.00	Ain Deek & Teis Drinking Water Treatment Plant	RW	2.02	24.3	435.2
177285	WJ025291	21-MAR-2019 08:05:00.00	Ain Deek & Teis Drinking Water Treatment Plant	POST_UV	1.61	<1.0	<1.0
177286	WJ025291	21-MAR-2019 08:10:00.00	Ain Deek & Teis Drinking Water Treatment Plant	POST_FILT	1.5	<1.0	<1.0
177287	WJ025291	21-MAR-2019 08:15:00.00	Ain Deek & Teis Drinking Water Treatment Plant	FINALPROD	1.5	Absence	Absence
177353	WJ025307	24-MAR-2019 08:00:00.00	Ain Deek & Teis Drinking Water Treatment Plant	RW		46.7	435.2
177354	WJ025307	24-MAR-2019 08:10:00.00	Ain Deek & Teis Drinking Water Treatment Plant	POST_UV		60.5	410.6
177355	WJ025307	24-MAR-2019 08:15:00.00	Ain Deek & Teis Drinking Water Treatment Plant	POST_FILT	1.71	30.9	248.1
177356	WJ025307	24-MAR-2019 08:20:00.00	Ain Deek & Teis Drinking Water Treatment Plant	FINALPROD	1.34	Absence	Absence
177444	WJ025326	26-MAR-2019 08:10:00.00	Ain Deek & Teis Drinking Water Treatment Plant	RW	2.22	29.2	387.3
177445	WJ025326	26-MAR-2019 08:15:00.00	Ain Deek & Teis Drinking Water Treatment Plant	POST_UV	2.01	23.8	325.5
177446	WJ025326	26-MAR-2019 08:20:00.00	Ain Deek & Teis Drinking Water Treatment Plant	POST_FILT	1.12	34.1	488.4
177447	WJ025326	26-MAR-2019 08:30:00.00	Ain Deek & Teis Drinking Water Treatment Plant	FINALPROD	1	Absence	Absence
177554	WJ025345	28-MAR-2019 08:15:00.00	Ain Deek & Teis Drinking Water Treatment Plant	RW	1.14	38.4	365.4
177555	WJ025345	28-MAR-2019 08:20:00.00	Ain Deek & Teis Drinking Water Treatment Plant	POST_UV	1.1	42.6	290.9
177556	WJ025345	28-MAR-2019 08:30:00.00	Ain Deek & Teis Drinking Water Treatment Plant	POST_FILT	0.72	42	461.1
177557	WJ025345	28-MAR-2019 08:35:00.00	Ain Deek & Teis Drinking Water Treatment Plant	FINALPROD	0.7	Absence	Absence
177605	WJ025359	31-MAR-2019 10:30:00.00	Ain Deek & Teis Drinking Water Treatment Plant	RW	2.24	57.3	488.4
177606	WJ025359	31-MAR-2019 10:35:00.00	Ain Deek & Teis Drinking Water Treatment Plant	POST_UV	2.1	<1.0	<1.0
177607	WJ025359	31-MAR-2019 10:40:00.00	Ain Deek & Teis Drinking Water Treatment Plant	POST_FILT	1.88	1	9.8
177608	WJ025359	31-MAR-2019 10:45:00.00	Ain Deek & Teis Drinking Water Treatment Plant	FINALPROD	1.7	Absence	Absence
177679	WJ025375	2-APR-2019 10:00:00.00	Ain Deek & Teis Drinking Water Treatment Plant	RW	2.2	15.6	157.6
177680	WJ025375	2-APR-2019 10:05:00.00	Ain Deek & Teis Drinking Water Treatment Plant	POST_UV	1.8	18.1	167
177681	WJ025375	2-APR-2019 10:10:00.00	Ain Deek & Teis Drinking Water Treatment Plant	POST_FILT	1.04	17.3	172.2
177682	WJ025375	2-APR-2019 10:15:00.00	Ain Deek & Teis Drinking Water Treatment Plant	FINALPROD	1.04	Absence	Absence
177743	WJ025384	4-APR-2019 07:30:00.00	Ain Deek & Teis Drinking Water Treatment Plant	RW	2.45	12.6	131.7
177744	WJ025384	4-APR-2019 07:35:00.00	Ain Deek & Teis Drinking Water Treatment Plant	POST_UV	2.11	11.9	117.8
177745	WJ025384	4-APR-2019 07:40:00.00	Ain Deek & Teis Drinking Water Treatment Plant	POST_FILT	1.4	3.1	88.4
177746	WJ025384	4-APR-2019 07:45:00.00	Ain Deek & Teis Drinking Water Treatment Plant	FINALPROD	1.4	Absence	Absence
177855	WJ025400	7-APR-2019 07:35:00.00	Ain Deek & Teis Drinking Water Treatment Plant	RW	1.37	27.5	435.2
177856	WJ025400	7-APR-2019 07:40:00.00	Ain Deek & Teis Drinking Water Treatment Plant	POST_UV	1.2	<1.0	<1.0
177857	WJ025400	7-APR-2019 07:45:00.00	Ain Deek & Teis Drinking Water Treatment Plant	POST_FILT	1.11	<1.0	<1.0
177858	WJ025400	7-APR-2019 07:50:00.00	Ain Deek & Teis Drinking Water Treatment Plant	FINALPROD	1.03	Absence	Absence
177927	WJ025411	9-APR-2019 08:20:00.00	Ain Deek & Teis Drinking Water Treatment Plant	RW	1.37	18.7	119.8
177928	WJ025411	9-APR-2019 08:25:00.00	Ain Deek & Teis Drinking Water Treatment Plant	POST_UV	1.2	<1.0	<1.0
177929	WJ025411	9-APR-2019 08:30:00.00	Ain Deek & Teis Drinking Water Treatment Plant	POST_FILT	1.15	<1.0	2
177935	WJ025411	9-APR-2019 08:35:00.00	Ain Deek & Teis Drinking Water Treatment Plant	FINALPROD	0.98	Absence	Absence
178114	WJ025438	11-APR-2019 09:00:00.00	Ain Deek & Teis Drinking Water Treatment Plant	RW	2.01	52.9	770.1
178115	WJ025438	11-APR-2019 09:10:00.00	Ain Deek & Teis Drinking Water Treatment Plant	POST_UV	2	75.9	547.5
178116	WJ025438	11-APR-2019 09:20:00.00	Ain Deek & Teis Drinking Water Treatment Plant	POST_FILT	1.03	59.1	517.2
178117	WJ025438	11-APR-2019 09:30:00.00	Ain Deek & Teis Drinking Water Treatment Plant	FINALPROD	1.01	Absence	Absence
178130	WJ025441	14-APR-2019 07:35:00.00	Ain Deek & Teis Drinking Water Treatment Plant	RW	1.13	19.9	325.5
178131	WJ025441	14-APR-2019 07:40:00.00	Ain Deek & Teis Drinking Water Treatment Plant	POST_UV	0.99	<1.0	<1.0
178132	WJ025441	14-APR-2019 07:45:00.00	Ain Deek & Teis Drinking Water Treatment Plant	POST_FILT	0.95	<1.0	3.1
178133	WJ025441	14-APR-2019 07:50:00.00	Ain Deek & Teis Drinking Water Treatment Plant	FINALPROD	0.91	Absence	Absence
178387	WJ025488	18-APR-2019 08:00:00.00	Ain Deek & Teis Drinking Water Treatment Plant	RW	2.18	18.5	214.3
178388	WJ025488	18-APR-2019 08:05:00.00	Ain Deek & Teis Drinking Water Treatment Plant	POST_UV	2	<1.0	<1.0
178389	WJ025488	18-APR-2019 08:10:00.00	Ain Deek & Teis Drinking Water Treatment Plant	POST_FILT	1.11	<1.0	<1.0
178390	WJ025488	18-APR-2019 08:15:00.00	Ain Deek & Teis Drinking Water Treatment Plant	FINALPROD	0.91	Absence	Absence
178441	WJ025500	21-APR-2019 08:30:00.00	Ain Deek & Teis Drinking Water Treatment Plant	RW	1.12	1	35.5
178442	WJ025500	21-APR-2019 08:35:00.00	Ain Deek & Teis Drinking Water Treatment Plant	POST_UV	1	<1.0	<1.0
178444	WJ025500	21-APR-2019 08:40:00.00	Ain Deek & Teis Drinking Water Treatment Plant	POST_FILT	0.64	1	12
178445	WJ025500	21-APR-2019 08:45:00.00	Ain Deek & Teis Drinking Water Treatment Plant	FINALPROD	0.61	Absence	Absence
178583	WJ025517	23-APR-2019 09:00:00.00	Ain Deek & Teis Drinking Water Treatment Plant	RW	2.14	22.1	209.8
178584	WJ025517	23-APR-2019 09:05:00.00	Ain Deek & Teis Drinking Water Treatment Plant	POST_UV	2.1	8.4	27.5
178585	WJ025517	23-APR-2019 09:10:00.00	Ain Deek & Teis Drinking Water Treatment Plant	POST_FILT	0.7	8.6	36.4
178587	WJ025517	23-APR-2019 09:15:00.00	Ain Deek & Teis Drinking Water Treatment Plant	FINALPROD	0.7	Absence	Absence
178702	WJ025538	25-APR-2019 09:15:00.00	Ain Deek & Teis Drinking Water Treatment Plant	RW	2.44	44.1	248.1
178704	WJ025538	25-APR-2019 09:20:00.00	Ain Deek & Teis Drinking Water Treatment Plant	POST_UV	2	<1.0	<1.0
178706	WJ025538	25-APR-2019 09:25:00.00	Ain Deek & Teis Drinking Water Treatment Plant	POST_FILT	1.12	<1.0	3
178707	WJ025538	25-APR-2019 09:30:00.00	Ain Deek & Teis Drinking Water Treatment Plant	FINALPROD	1	Absence	Absence
179150	WJ025615	6-MAY-2019 08:00:00.00	Ain Deek & Teis Drinking Water Treatment Plant	RW	1.88	35	238.2
179151	WJ025615	6-MAY-2019 08:05:00.00	Ain Deek & Teis Drinking Water Treatment Plant	POST_UV	1.7	17.3	73.3
179152	WJ025615	6-MAY-2019 08:10:00.00	Ain Deek & Teis Drinking Water Treatment Plant	POST_FILT	0.9	21.6	145
179153	WJ025615	6-MAY-2019 08:15:00.00	Ain Deek & Teis Drinking Water Treatment Plant	FINALPROD	0.8	Absence	Absence
179336	WJ025643	9-MAY-2019 08:30:00.00	Ain Deek & Teis Drinking Water Treatment Plant	RW	1.9	23.3	214.3

179337	WJ025643	9-MAY-2019 08:35:00.00	Ain Deek & Teis Drinking Water Treatment Plant	POST UV	1.7	21.3	195.6
179338	WJ025643	9-MAY-2019 08:40:00.00	Ain Deek & Teis Drinking Water Treatment Plant	POST_FILT	1.01	12.1	201.4
179339	WJ025643	9-MAY-2019 08:50:00.00	Ain Deek & Teis Drinking Water Treatment Plant	FINALPROD	0.99	Absence	Absence
179429	WJ025664	12-MAY-2019 08:15:00.00	Ain Deek & Teis Drinking Water Treatment Plant	RW	2.45	3	47.1
179430	WJ025664	12-MAY-2019 08:20:00.00	Ain Deek & Teis Drinking Water Treatment Plant	POST UV	2.1	<1.0	<1.0
179431	WJ025664	12-MAY-2019 08:30:00.00	Ain Deek & Teis Drinking Water Treatment Plant	POST_FILT	1.1	75.2	686.7
179432	WJ025664	12-MAY-2019 08:35:00.00	Ain Deek & Teis Drinking Water Treatment Plant	FINALPROD	1.08	Absence	Absence
179516	WJ025677	14-MAY-2019 08:00:00.00	Ain Deek & Teis Drinking Water Treatment Plant	RW	1.9	14.6	307.6
179517	WJ025677	14-MAY-2019 08:05:00.00	Ain Deek & Teis Drinking Water Treatment Plant	POST UV	1.88	<1.0	<1.0
179519	WJ025677	14-MAY-2019 08:10:00.00	Ain Deek & Teis Drinking Water Treatment Plant	POST_FILT	0.95	3.1	365.4
179520	WJ025677	14-MAY-2019 08:15:00.00	Ain Deek & Teis Drinking Water Treatment Plant	FINALPROD	0.8	Absence	Absence
179659	WJ025703	16-MAY-2019 08:30:00.00	Ain Deek & Teis Drinking Water Treatment Plant	RW	2.24	14.6	235.9
179660	WJ025703	16-MAY-2019 08:35:00.00	Ain Deek & Teis Drinking Water Treatment Plant	POST UV	2.18	<1.0	<1.0
179661	WJ025703	16-MAY-2019 08:40:00.00	Ain Deek & Teis Drinking Water Treatment Plant	POST_FILT	1.01	5.2	121.1
179662	WJ025703	16-MAY-2019 08:50:00.00	Ain Deek & Teis Drinking Water Treatment Plant	FINALPROD	1	Absence	Absence
179707	WJ025710	19-MAY-2019 07:30:00.00	Ain Deek & Teis Drinking Water Treatment Plant	RW	2.55	10.8	114.5
179708	WJ025710	19-MAY-2019 07:35:00.00	Ain Deek & Teis Drinking Water Treatment Plant	POST UV	2.14	<1.0	<1.0
179709	WJ025710	19-MAY-2019 07:40:00.00	Ain Deek & Teis Drinking Water Treatment Plant	POST_FILT	1.01	16.1	127.4
179710	WJ025710	19-MAY-2019 07:50:00.00	Ain Deek & Teis Drinking Water Treatment Plant	FINALPROD	0.9	Absence	Absence
179800	WJ025726	21-MAY-2019 08:30:00.00	Ain Deek & Teis Drinking Water Treatment Plant	RW	2.12	14.6	93.3
179801	WJ025726	21-MAY-2019 08:35:00.00	Ain Deek & Teis Drinking Water Treatment Plant	POST UV	2	<1.0	<1.0
179802	WJ025726	21-MAY-2019 08:40:00.00	Ain Deek & Teis Drinking Water Treatment Plant	POST_FILT	1.1	3.1	111.2
179803	WJ025726	21-MAY-2019 08:45:00.00	Ain Deek & Teis Drinking Water Treatment Plant	FINALPROD	0.8	Absence	Absence
179947	WJ025750	23-MAY-2019 08:30:00.00	Ain Deek & Teis Drinking Water Treatment Plant	RW	2.02	2	107.6
179948	WJ025750	23-MAY-2019 08:35:00.00	Ain Deek & Teis Drinking Water Treatment Plant	POST UV	2.02	<1.0	<1.0
179949	WJ025750	23-MAY-2019 08:40:00.00	Ain Deek & Teis Drinking Water Treatment Plant	POST_FILT	1.03	8.3	129.6
179950	WJ025750	23-MAY-2019 08:50:00.00	Ain Deek & Teis Drinking Water Treatment Plant	FINALPROD	0.8	Absence	Absence
180009	WJ025759	26-MAY-2019 11:00:00.00	Ain Deek & Teis Drinking Water Treatment Plant	RW	1.88	10.7	161.6
180010	WJ025759	26-MAY-2019 11:05:00.00	Ain Deek & Teis Drinking Water Treatment Plant	POST UV	1.7	<1.0	<1.0
180011	WJ025759	26-MAY-2019 11:10:00.00	Ain Deek & Teis Drinking Water Treatment Plant	POST_FILT	0.9	3.1	71.7
180012	WJ025759	26-MAY-2019 11:15:00.00	Ain Deek & Teis Drinking Water Treatment Plant	FINALPROD	0.95	Absence	Absence
180133	WJ025781	28-MAY-2019 09:00:00.00	Ain Deek & Teis Drinking Water Treatment Plant	RW	2.3	4.1	165.8
180134	WJ025781	28-MAY-2019 09:10:00.00	Ain Deek & Teis Drinking Water Treatment Plant	POST UV	2.15	<1.0	<1.0
180135	WJ025781	28-MAY-2019 09:15:00.00	Ain Deek & Teis Drinking Water Treatment Plant	POST_FILT	1.01	3.1	81.6
180137	WJ025781	28-MAY-2019 09:30:00.00	Ain Deek & Teis Drinking Water Treatment Plant	FINALPROD	1.12	Absence	Absence
180225	WJ025802	30-MAY-2019 09:30:00.00	Ain Deek & Teis Drinking Water Treatment Plant	RW		<1.0	24.6
180226	WJ025802	30-MAY-2019 09:35:00.00	Ain Deek & Teis Drinking Water Treatment Plant	POST UV		<1.0	<1.0
180227	WJ025802	30-MAY-2019 09:40:00.00	Ain Deek & Teis Drinking Water Treatment Plant	POST_FILT		<1.0	<1.0
180228	WJ025802	30-MAY-2019 09:50:00.00	Ain Deek & Teis Drinking Water Treatment Plant	FINALPROD		Absence	Absence
180407	WJ025835	11-JUN-2019 07:00:00.00	Ain Deek & Teis Drinking Water Treatment Plant	RW	2.4	16.9	275.5
180408	WJ025835	11-JUN-2019 07:05:00.00	Ain Deek & Teis Drinking Water Treatment Plant	POST UV	2	<1.0	<1.0
180409	WJ025835	11-JUN-2019 07:10:00.00	Ain Deek & Teis Drinking Water Treatment Plant	POST_FILT	1.1	5.2	201.4
180411	WJ025835	11-JUN-2019 07:15:00.00	Ain Deek & Teis Drinking Water Treatment Plant	FINALPROD	1.12	Absence	Absence
180519	WJ025850	13-JUN-2019 07:00:00.00	Ain Deek & Teis Drinking Water Treatment Plant	RW	1.8	8.4	579.4
180520	WJ025850	13-JUN-2019 07:05:00.00	Ain Deek & Teis Drinking Water Treatment Plant	POST UV	1.71	3	275.5
180522	WJ025850	13-JUN-2019 07:10:00.00	Ain Deek & Teis Drinking Water Treatment Plant	POST_FILT	1.02	5.2	135.4
180523	WJ025850	13-JUN-2019 07:15:00.00	Ain Deek & Teis Drinking Water Treatment Plant	FINALPROD	0.8	Absence	Absence
180688	WJ025879	18-JUN-2019 08:30:00.00	Ain Deek & Teis Drinking Water Treatment Plant	RW	2.45	1	261.3
180691	WJ025879	18-JUN-2019 08:35:00.00	Ain Deek & Teis Drinking Water Treatment Plant	POST UV	2.4	3.1	410.6
180692	WJ025879	18-JUN-2019 08:40:00.00	Ain Deek & Teis Drinking Water Treatment Plant	POST_FILT	1.11	5.2	1119.9
180694	WJ025879	18-JUN-2019 08:50:00.00	Ain Deek & Teis Drinking Water Treatment Plant	FINALPROD	1	Absence	Absence
180895	WJ025914	20-JUN-2019 08:45:00.00	Ain Deek & Teis Drinking Water Treatment Plant	RW	1.88	2	167
180896	WJ025914	20-JUN-2019 08:50:00.00	Ain Deek & Teis Drinking Water Treatment Plant	POST UV	1.4	2	123.6
180897	WJ025914	20-JUN-2019 09:00:00.00	Ain Deek & Teis Drinking Water Treatment Plant	POST_FILT	0.8	2	118.7
180898	WJ025914	20-JUN-2019 09:10:00.00	Ain Deek & Teis Drinking Water Treatment Plant	FINALPROD	0.98	Absence	Absence
180948	WJ025924	23-JUN-2019 08:00:00.00	Ain Deek & Teis Drinking Water Treatment Plant	RW	2.14	2	178.9
180949	WJ025924	23-JUN-2019 08:05:00.00	Ain Deek & Teis Drinking Water Treatment Plant	POST UV	2	2	148.3
180951	WJ025924	23-JUN-2019 08:10:00.00	Ain Deek & Teis Drinking Water Treatment Plant	POST_FILT	1.14	2	172.3
180953	WJ025924	23-JUN-2019 08:15:00.00	Ain Deek & Teis Drinking Water Treatment Plant	FINALPROD	0.99	Absence	Absence
181101	WJ025948	25-JUN-2019 08:30:00.00	Ain Deek & Teis Drinking Water Treatment Plant	RW	1.8	119.8	435.2
181102	WJ025948	25-JUN-2019 08:40:00.00	Ain Deek & Teis Drinking Water Treatment Plant	POST UV	1.77	111.9	488.4
181103	WJ025948	25-JUN-2019 08:50:00.00	Ain Deek & Teis Drinking Water Treatment Plant	POST_FILT	0.98	131.7	770.1
181104	WJ025948	25-JUN-2019 09:00:00.00	Ain Deek & Teis Drinking Water Treatment Plant	FINALPROD	1.01	Absence	Absence
181148	WJ025961	26-JUN-2019 11:10:00.00	Ain Deek & Teis Drinking Water Treatment Plant	RW	2.7	167.4	770.1
181150	WJ025961	26-JUN-2019 11:20:00.00	Ain Deek & Teis Drinking Water Treatment Plant	POST UV	2.6	145	435.2
181151	WJ025961	26-JUN-2019 11:25:00.00	Ain Deek & Teis Drinking Water Treatment Plant	POST_FILT	1.01	131.4	613.1
181152	WJ025961	26-JUN-2019 11:30:00.00	Ain Deek & Teis Drinking Water Treatment Plant	FINALPROD	0.9	Absence	Absence
181214	WJ025974	27-JUN-2019 09:30:00.00	Ain Deek & Teis Drinking Water Treatment Plant	RW	2.4	25.3	224.7

181215	WJ025974	27-JUN-2019 09:35:00.00	Ain Deek & Teis Drinking Water Treatment Plant	POST UV	1.99	28.8	261.3
181217	WJ025974	27-JUN-2019 09:40:00.00	Ain Deek & Teis Drinking Water Treatment Plant	POST_FILT	3.88	40.4	115.3
181218	WJ025974	27-JUN-2019 09:50:00.00	Ain Deek & Teis Drinking Water Treatment Plant	FINALPROD	2.95	Absence	Absence
181294	WJ025988	29-JUN-2019 09:40:00.00	Ain Deek & Teis Drinking Water Treatment Plant	RW	1.42	<1.0	<1.0
181295	WJ025988	29-JUN-2019 09:50:00.00	Ain Deek & Teis Drinking Water Treatment Plant	FINALPROD	1.51	Absence	Absence
181313	WJ025989	30-JUN-2019 10:30:00.00	Ain Deek & Teis Drinking Water Treatment Plant	FINALPROD	2.5	Absence	Presence
181371	WJ026002	1-JUL-2019 09:20:00.00	Ain Deek & Teis Drinking Water Treatment Plant	RW	2.01	24.3	195.6
181372	WJ026002	1-JUL-2019 09:30:00.00	Ain Deek & Teis Drinking Water Treatment Plant	FINALPROD	1.81	Absence	Absence
181471	WJ026012	2-JUL-2019 10:20:00.00	Ain Deek & Teis Drinking Water Treatment Plant	RW	2.05	114.5	260.3
181472	WJ026012	2-JUL-2019 11:20:00.00	Ain Deek & Teis Drinking Water Treatment Plant	RW	2.04	107.6	435.2
181473	WJ026012	2-JUL-2019 10:30:00.00	Ain Deek & Teis Drinking Water Treatment Plant	POST_FILT	1.51	12.2	47.3
181474	WJ026012	2-JUL-2019 11:30:00.00	Ain Deek & Teis Drinking Water Treatment Plant	POST_FILT	1.48	58.3	248.1
181475	WJ026012	2-JUL-2019 11:40:00.00	Ain Deek & Teis Drinking Water Treatment Plant	FINALPROD	1.4	Absence	Absence
181538	WJ026018	3-JUL-2019 09:20:00.00	Ain Deek & Teis Drinking Water Treatment Plant	RW	2.14	29.2	116
181540	WJ026018	3-JUL-2019 09:30:00.00	Ain Deek & Teis Drinking Water Treatment Plant	POST_FILT	1.42	18.7	68.3
181541	WJ026018	3-JUL-2019 09:40:00.00	Ain Deek & Teis Drinking Water Treatment Plant	FINALPROD	1.11	Absence	Absence
181598	WJ026028	4-JUL-2019 09:30:00.00	Ain Deek & Teis Drinking Water Treatment Plant	RW		27.2	214.2
181599	WJ026028	4-JUL-2019 09:35:00.00	Ain Deek & Teis Drinking Water Treatment Plant	FINALPROD		Absence	Absence
181632	WJ026034	7-JUL-2019 09:30:00.00	Ain Deek & Teis Drinking Water Treatment Plant	RW	2.4	<1.0	5.2
181634	WJ026034	7-JUL-2019 09:40:00.00	Ain Deek & Teis Drinking Water Treatment Plant	FINALPROD	1.18	Absence	Absence
181710	WJ026046	8-JUL-2019 09:30:00.00	Ain Deek & Teis Drinking Water Treatment Plant	RW	1.61	72.7	218.7
181712	WJ026046	8-JUL-2019 09:40:00.00	Ain Deek & Teis Drinking Water Treatment Plant	FINALPROD	1.1	Absence	Absence
181818	WJ026064	9-JUL-2019 09:30:00.00	Ain Deek & Teis Drinking Water Treatment Plant	RW	0.9	14.6	98.7
181819	WJ026064	9-JUL-2019 09:35:00.00	Ain Deek & Teis Drinking Water Treatment Plant	RW	1.88	21.1	88.2
181820	WJ026064	9-JUL-2019 09:40:00.00	Ain Deek & Teis Drinking Water Treatment Plant	FINALPROD	1.88	Absence	Absence
181838	WJ026069	10-JUL-2019 08:00:00.00	Ain Deek & Teis Drinking Water Treatment Plant	RW	2.4	39.7	191.8
181839	WJ026069	10-JUL-2019 08:05:00.00	Ain Deek & Teis Drinking Water Treatment Plant	RW	2.4	22.1	275.5
181840	WJ026069	10-JUL-2019 08:10:00.00	Ain Deek & Teis Drinking Water Treatment Plant	FINALPROD	1.18	Absence	Absence
181932	WJ026086	11-JUL-2019 09:30:00.00	Ain Deek & Teis Drinking Water Treatment Plant	RW	2.01	18.5	178.5
181933	WJ026086	11-JUL-2019 09:35:00.00	Ain Deek & Teis Drinking Water Treatment Plant	FINALPROD	1.02	Absence	Absence
182012	WJ026100	14-JUL-2019 09:30:00.00	Ain Deek & Teis Drinking Water Treatment Plant	RW	2.4	19.7	131.4
182013	WJ026100	14-JUL-2019 09:35:00.00	Ain Deek & Teis Drinking Water Treatment Plant	FINALPROD	1.2	Absence	Absence
182149	WJ026125	16-JUL-2019 08:30:00.00	Ain Deek & Teis Drinking Water Treatment Plant	RW	2.66	12.2	50.4
182150	WJ026125	16-JUL-2019 08:35:00.00	Ain Deek & Teis Drinking Water Treatment Plant	FINALPROD	1.41	Presence	Presence
182225	WJ026140	17-JUL-2019 09:00:00.00	Ain Deek & Teis Drinking Water Treatment Plant	RW	2.4	21.8	54.8
182227	WJ026140	17-JUL-2019 09:10:00.00	Ain Deek & Teis Drinking Water Treatment Plant	RW	1.88	93.3	298.7
182229	WJ026140	17-JUL-2019 09:20:00.00	Ain Deek & Teis Drinking Water Treatment Plant	POST_FILT	1.1	21.3	131.4
182230	WJ026140	17-JUL-2019 09:30:00.00	Ain Deek & Teis Drinking Water Treatment Plant	FINALPROD	1.61	Absence	Absence
182233	WJ026140	17-JUL-2019 09:40:00.00	Ain Deek & Teis Drinking Water Treatment Plant	FINALPROD	1.62	Absence	Presence
182297	WJ026153	18-JUL-2019 08:40:00.00	Ain Deek & Teis Drinking Water Treatment Plant	POST_FILT	0.91	52	344.8
182298	WJ026153	18-JUL-2019 08:45:00.00	Ain Deek & Teis Drinking Water Treatment Plant	FINALPROD	1.11	Absence	Absence
182422	WJ026169	21-JUL-2019 08:00:00.00	Ain Deek & Teis Drinking Water Treatment Plant	RW	2.41	488.4	1203.3
182423	WJ026169	21-JUL-2019 08:05:00.00	Ain Deek & Teis Drinking Water Treatment Plant	POST UV	1.45	<1.0	<1.0
182424	WJ026169	21-JUL-2019 08:10:00.00	Ain Deek & Teis Drinking Water Treatment Plant	POST_FILT	1.01	3.1	8.6
182425	WJ026169	21-JUL-2019 08:15:00.00	Ain Deek & Teis Drinking Water Treatment Plant	FINALPROD	1.11	Absence	Absence
182512	WJ026187	23-JUL-2019 08:05:00.00	Ain Deek & Teis Drinking Water Treatment Plant	RW	2.16	238.2	816.4
182513	WJ026187	23-JUL-2019 08:10:00.00	Ain Deek & Teis Drinking Water Treatment Plant	POST UV	2.1	<1.0	<1.0
182515	WJ026187	23-JUL-2019 08:15:00.00	Ain Deek & Teis Drinking Water Treatment Plant	POST_FILT	1.14	<1.0	22.6
182516	WJ026187	23-JUL-2019 08:20:00.00	Ain Deek & Teis Drinking Water Treatment Plant	FINALPROD	1.2	Absence	Absence
182671	WJ026213	25-JUL-2019 08:00:00.00	Ain Deek & Teis Drinking Water Treatment Plant	RW	2.44	18.9	78.9
182672	WJ026213	25-JUL-2019 08:05:00.00	Ain Deek & Teis Drinking Water Treatment Plant	POST UV	2.11	<1.0	<1.0
182673	WJ026213	25-JUL-2019 08:10:00.00	Ain Deek & Teis Drinking Water Treatment Plant	POST_FILT	1.2	<1.0	1
182674	WJ026213	25-JUL-2019 08:15:00.00	Ain Deek & Teis Drinking Water Treatment Plant	FINALPROD	1.24	Absence	Absence
182776	WJ026225	28-JUL-2019 08:00:00.00	Ain Deek & Teis Drinking Water Treatment Plant	RW	2.8	1203.3	>2419.6
182777	WJ026225	28-JUL-2019 08:10:00.00	Ain Deek & Teis Drinking Water Treatment Plant	POST UV	2.1	<1.0	<1.0
182778	WJ026225	28-JUL-2019 08:15:00.00	Ain Deek & Teis Drinking Water Treatment Plant	POST_FILT	1.02	<1.0	25.1
182779	WJ026225	28-JUL-2019 08:20:00.00	Ain Deek & Teis Drinking Water Treatment Plant	FINALPROD	1.11	Absence	Absence
182843	WJ026240	30-JUL-2019 09:30:00.00	Ain Deek & Teis Drinking Water Treatment Plant	RW	2.46	201.4	547.5
182844	WJ026240	30-JUL-2019 09:40:00.00	Ain Deek & Teis Drinking Water Treatment Plant	POST UV	2.2	<1.0	<1.0
182845	WJ026240	30-JUL-2019 09:50:00.00	Ain Deek & Teis Drinking Water Treatment Plant	POST_FILT	1.04	<1.0	4.1
182846	WJ026240	30-JUL-2019 10:00:00.00	Ain Deek & Teis Drinking Water Treatment Plant	FINALPROD	1.14	Absence	Absence
182943	WJ026257	1-AUG-2019 07:40:00.00	Ain Deek & Teis Drinking Water Treatment Plant	RW	2.61	56.3	579.4
182944	WJ026257	1-AUG-2019 08:00:00.00	Ain Deek & Teis Drinking Water Treatment Plant	POST UV	2.55	<1.0	<1.0
182945	WJ026257	1-AUG-2019 08:05:00.00	Ain Deek & Teis Drinking Water Treatment Plant	POST_FILT	1.04	<1.0	5.2
182946	WJ026257	1-AUG-2019 08:10:00.00	Ain Deek & Teis Drinking Water Treatment Plant	FINALPROD	1.11	Absence	Absence
183027	WJ026266	4-AUG-2019 09:00:00.00	Ain Deek & Teis Drinking Water Treatment Plant	RW	2.4	28.1	121.1
183028	WJ026266	4-AUG-2019 09:10:00.00	Ain Deek & Teis Drinking Water Treatment Plant	POST UV	2.1	<1.0	<1.0
183029	WJ026266	4-AUG-2019 09:20:00.00	Ain Deek & Teis Drinking Water Treatment Plant	POST_FILT	1.41	<1.0	6.3

183030	WJ026266	4-AUG-2019 09:30:00.00	Ain Deek & Teis Drinking Water Treatment Plant	FINALPROD	1.11	Absence	Absence
183176	WJ026297	6-AUG-2019 09:00:00.00	Ain Deek & Teis Drinking Water Treatment Plant	RW		60.5	178.5
183177	WJ026297	6-AUG-2019 09:05:00.00	Ain Deek & Teis Drinking Water Treatment Plant	POST_UV		<1.0	<1.0
183178	WJ026297	6-AUG-2019 09:10:00.00	Ain Deek & Teis Drinking Water Treatment Plant	POST_FILT		<1.0	7.5
183179	WJ026297	6-AUG-2019 09:15:00.00	Ain Deek & Teis Drinking Water Treatment Plant	FINALPROD		Absence	Absence
183300	WJ026316	15-AUG-2019 08:30:00.00	Ain Deek & Teis Drinking Water Treatment Plant	RW		17.1	83.6
183301	WJ026316	15-AUG-2019 08:35:00.00	Ain Deek & Teis Drinking Water Treatment Plant	POST_UV		<1.0	<1.0
183302	WJ026316	15-AUG-2019 08:40:00.00	Ain Deek & Teis Drinking Water Treatment Plant	POST_FILT		<1.0	>2419.6
183303	WJ026316	15-AUG-2019 08:45:00.00	Ain Deek & Teis Drinking Water Treatment Plant	FINALPROD		Absence	Absence
183304	WJ026316	15-AUG-2019 08:50:00.00	Ain Deek & Teis Drinking Water Treatment Plant	RW		Absence	Absence
183409	WJ026329	8-AUG-2019 08:30:00.00	Ain Deek & Teis Drinking Water Treatment Plant	RW	2.81	39.1	117.8
183411	WJ026329	8-AUG-2019 08:35:00.00	Ain Deek & Teis Drinking Water Treatment Plant	POST_UV	2.77	<1.0	<1.0
183413	WJ026329	8-AUG-2019 08:40:00.00	Ain Deek & Teis Drinking Water Treatment Plant	POST_FILT	1.11	<1.0	53.6
183414	WJ026329	8-AUG-2019 08:45:00.00	Ain Deek & Teis Drinking Water Treatment Plant	FINALPROD	1.4	Absence	Absence
183431	WJ026331	12-AUG-2019 09:00:00.00	Ain Deek & Teis Drinking Water Treatment Plant	RW	2.61	23.3	83.9
183432	WJ026331	12-AUG-2019 09:05:00.00	Ain Deek & Teis Drinking Water Treatment Plant	FINALPROD	1.21	Absence	Presence
183441	WJ026333	14-AUG-2019 09:00:00.00	Ain Deek & Teis Drinking Water Treatment Plant	FINALPROD	2.45	Absence	Absence
183442	WJ026333	14-AUG-2019 09:10:00.00	Ain Deek & Teis Drinking Water Treatment Plant	FINALPROD	1.21	Absence	Presence
183455	WJ026337	18-AUG-2019 10:10:00.00	Ain Deek & Teis Drinking Water Treatment Plant	RW	0.5	365.4	770.1
183456	WJ026337	18-AUG-2019 10:15:00.00	Ain Deek & Teis Drinking Water Treatment Plant	FINALPROD	0.31	Absence	Absence
183458	WJ026333	14-AUG-2019 09:00:00.00	Ain Deek & Teis Drinking Water Treatment Plant	RW	1.21	25.9	110
183556	WJ026363	20-AUG-2019 08:00:00.00	Ain Deek & Teis Drinking Water Treatment Plant	RW		218.7	488.4
183557	WJ026363	20-AUG-2019 08:05:00.00	Ain Deek & Teis Drinking Water Treatment Plant	POST_UV		<1.0	<1.0
183558	WJ026363	20-AUG-2019 08:10:00.00	Ain Deek & Teis Drinking Water Treatment Plant	POST_FILT		<1.0	6.3
183559	WJ026363	20-AUG-2019 08:15:00.00	Ain Deek & Teis Drinking Water Treatment Plant	FINALPROD		Absence	Absence
183732	WJ026388	22-AUG-2019 08:00:00.00	Ain Deek & Teis Drinking Water Treatment Plant	RW		35.5	141.4
183733	WJ026388	22-AUG-2019 08:10:00.00	Ain Deek & Teis Drinking Water Treatment Plant	POST_UV		<1.0	<1.0
183734	WJ026388	22-AUG-2019 08:15:00.00	Ain Deek & Teis Drinking Water Treatment Plant	POST_FILT		<1.0	21.8
183735	WJ026388	22-AUG-2019 08:20:00.00	Ain Deek & Teis Drinking Water Treatment Plant	FINALPROD		Absence	Absence
183737	WJ026388	22-AUG-2019 08:30:00.00	Ain Deek & Teis Drinking Water Treatment Plant	RW		48	209.8
183800	WJ026408	25-AUG-2019 09:00:00.00	Ain Deek & Teis Drinking Water Treatment Plant	RW	2.67	7.2	98.7
183802	WJ026408	25-AUG-2019 09:05:00.00	Ain Deek & Teis Drinking Water Treatment Plant	POST_UV	2.5	<1.0	<1.0
183803	WJ026408	25-AUG-2019 09:15:00.00	Ain Deek & Teis Drinking Water Treatment Plant	FINALPROD	1.11	Absence	Absence
183815	WJ026408	25-AUG-2019 09:10:00.00	Ain Deek & Teis Drinking Water Treatment Plant	POST_FILT	1.32	<1.0	114.5
184003	WJ026444	27-AUG-2019 08:15:00.00	Ain Deek & Teis Drinking Water Treatment Plant	RW		36.9	111.9
184004	WJ026444	27-AUG-2019 08:20:00.00	Ain Deek & Teis Drinking Water Treatment Plant	POST_UV		<1.0	<1.0
184005	WJ026444	27-AUG-2019 08:30:00.00	Ain Deek & Teis Drinking Water Treatment Plant	POST_FILT		<1.0	12.1
184006	WJ026444	27-AUG-2019 08:35:00.00	Ain Deek & Teis Drinking Water Treatment Plant	FINALPROD		Absence	Absence
184121	WJ026457	29-AUG-2019 09:05:00.00	Ain Deek & Teis Drinking Water Treatment Plant	RW		2143	6867
184122	WJ026457	29-AUG-2019 09:10:00.00	Ain Deek & Teis Drinking Water Treatment Plant	POST_FILT		<1.0	1
184123	WJ026457	29-AUG-2019 09:25:00.00	Ain Deek & Teis Drinking Water Treatment Plant	POST_UV		<1.0	<1.0
184124	WJ026457	29-AUG-2019 09:30:00.00	Ain Deek & Teis Drinking Water Treatment Plant	FINALPROD		Absence	Presence
184172	WJ026466	1-SEP-2019 08:00:00.00	Ain Deek & Teis Drinking Water Treatment Plant	RW		67	290.9
184173	WJ026466	1-SEP-2019 08:05:00.00	Ain Deek & Teis Drinking Water Treatment Plant	POST_UV		<1.0	<1.0
184174	WJ026466	1-SEP-2019 08:10:00.00	Ain Deek & Teis Drinking Water Treatment Plant	POST_FILT		<1.0	35
184175	WJ026466	1-SEP-2019 08:20:00.00	Ain Deek & Teis Drinking Water Treatment Plant	FINALPROD		Absence	Absence
184276	WJ026482	3-SEP-2019 07:00:00.00	Ain Deek & Teis Drinking Water Treatment Plant	RW		74.9	235.9
184278	WJ026482	3-SEP-2019 07:05:00.00	Ain Deek & Teis Drinking Water Treatment Plant	POST_UV		<1.0	<1.0
184281	WJ026482	3-SEP-2019 07:10:00.00	Ain Deek & Teis Drinking Water Treatment Plant	POST_FILT		<1.0	20.3
184286	WJ026482	3-SEP-2019 07:15:00.00	Ain Deek & Teis Drinking Water Treatment Plant	FINALPROD		Absence	Absence
184454	WJ026506	5-SEP-2019 08:00:00.00	Ain Deek & Teis Drinking Water Treatment Plant	RW		59.1	261.3
184455	WJ026506	5-SEP-2019 08:05:00.00	Ain Deek & Teis Drinking Water Treatment Plant	POST_FILT		<1.0	31.3
184456	WJ026506	5-SEP-2019 08:10:00.00	Ain Deek & Teis Drinking Water Treatment Plant	POST_UV		<1.0	<1.0
184457	WJ026506	5-SEP-2019 08:15:00.00	Ain Deek & Teis Drinking Water Treatment Plant	FINALPROD		Absence	Absence
184537	WJ026524	8-SEP-2019 08:00:00.00	Ain Deek & Teis Drinking Water Treatment Plant	RW		151.5	435.2
184538	WJ026524	8-SEP-2019 08:05:00.00	Ain Deek & Teis Drinking Water Treatment Plant	POST_UV		<1.0	<1.0
184539	WJ026524	8-SEP-2019 08:10:00.00	Ain Deek & Teis Drinking Water Treatment Plant	POST_FILT		<1.0	14.8
184540	WJ026524	8-SEP-2019 08:15:00.00	Ain Deek & Teis Drinking Water Treatment Plant	FINALPROD		Absence	Absence
184672	WJ026544	10-SEP-2019 07:30:00.00	Ain Deek & Teis Drinking Water Treatment Plant	RW		60.5	148.3
184673	WJ026544	10-SEP-2019 07:35:00.00	Ain Deek & Teis Drinking Water Treatment Plant	POST_UV		<1.0	<1.0
184674	WJ026544	10-SEP-2019 07:45:00.00	Ain Deek & Teis Drinking Water Treatment Plant	POST_FILT		<1.0	14.6
184682	WJ026544	10-SEP-2019 07:45:00.00	Ain Deek & Teis Drinking Water Treatment Plant	FINALPROD		Absence	Absence
184777	WJ026561	12-SEP-2019 08:00:00.00	Ain Deek & Teis Drinking Water Treatment Plant	RW		17.5	105.4
184778	WJ026561	12-SEP-2019 08:05:00.00	Ain Deek & Teis Drinking Water Treatment Plant	POST_UV		<1.0	<1.0
184779	WJ026561	12-SEP-2019 08:10:00.00	Ain Deek & Teis Drinking Water Treatment Plant	POST_FILT		<1.0	36.4
184780	WJ026561	12-SEP-2019 08:15:00.00	Ain Deek & Teis Drinking Water Treatment Plant	FINALPROD		Absence	Absence
184875	WJ026572	15-SEP-2019 08:00:00.00	Ain Deek & Teis Drinking Water Treatment Plant	RW		24.9	204.6
184876	WJ026572	15-SEP-2019 08:05:00.00	Ain Deek & Teis Drinking Water Treatment Plant	POST_UV		<1.0	<1.0

184877	WJ026572	15-SEP-2019 08:10:00.00	Ain Deek & Teis Drinking Water Treatment Plant	POST_FILTER		<1.0		16
184878	WJ026572	15-SEP-2019 08:15:00.00	Ain Deek & Teis Drinking Water Treatment Plant	FINALPROD		Absence		Absence
184966	WJ026590	17-SEP-2019 07:30:00.00	Ain Deek & Teis Drinking Water Treatment Plant	RW		325.5		1119.9
184967	WJ026590	17-SEP-2019 07:35:00.00	Ain Deek & Teis Drinking Water Treatment Plant	POST_UV		<1.0		<1.0
184969	WJ026590	17-SEP-2019 07:40:00.00	Ain Deek & Teis Drinking Water Treatment Plant	POST_FILTER		<1.0		7.4
184970	WJ026590	17-SEP-2019 07:45:00.00	Ain Deek & Teis Drinking Water Treatment Plant	FINALPROD		Absence		Absence
185072	WJ026610	19-SEP-2019 09:00:00.00	Ain Deek & Teis Drinking Water Treatment Plant	RW		23.1		114.5
185073	WJ026610	19-SEP-2019 09:05:00.00	Ain Deek & Teis Drinking Water Treatment Plant	POST_UV		<1.0		<1.0
185074	WJ026610	19-SEP-2019 09:10:00.00	Ain Deek & Teis Drinking Water Treatment Plant	POST_FILTER		<1.0		3.1
185075	WJ026610	19-SEP-2019 09:15:00.00	Ain Deek & Teis Drinking Water Treatment Plant	FINALPROD		Absence		Absence
185170	WJ026629	23-SEP-2019 08:00:00.00	Ain Deek & Teis Drinking Water Treatment Plant	RW		18.5		104.6
185171	WJ026629	23-SEP-2019 08:05:00.00	Ain Deek & Teis Drinking Water Treatment Plant	POST_UV		<1.0		<1.0
185172	WJ026629	23-SEP-2019 08:10:00.00	Ain Deek & Teis Drinking Water Treatment Plant	POST_FILTER		<1.0		65.7
185173	WJ026629	23-SEP-2019 08:15:00.00	Ain Deek & Teis Drinking Water Treatment Plant	FINALPROD		Absence		Absence
185237	WJ026646	24-SEP-2019 09:00:00.00	Ain Deek & Teis Drinking Water Treatment Plant	RW		39.3		178.5
185238	WJ026646	24-SEP-2019 09:05:00.00	Ain Deek & Teis Drinking Water Treatment Plant	POST_UV		<1.0		<1.0
185239	WJ026646	24-SEP-2019 09:10:00.00	Ain Deek & Teis Drinking Water Treatment Plant	POST_FILTER		<1.0		7.5
185240	WJ026646	24-SEP-2019 09:15:00.00	Ain Deek & Teis Drinking Water Treatment Plant	FINALPROD		Absence		Absence
185364	WJ026677	26-SEP-2019 09:00:00.00	Ain Deek & Teis Drinking Water Treatment Plant	RW				
185365	WJ026677	26-SEP-2019 09:05:00.00	Ain Deek & Teis Drinking Water Treatment Plant	POST_UV				
185366	WJ026677	26-SEP-2019 09:10:00.00	Ain Deek & Teis Drinking Water Treatment Plant	POST_FILTER				
185367	WJ026677	26-SEP-2019 09:15:00.00	Ain Deek & Teis Drinking Water Treatment Plant	FINALPROD				
185392	WJ026681	29-SEP-2019 09:00:00.00	Ain Deek & Teis Drinking Water Treatment Plant	RW				
185393	WJ026681	29-SEP-2019 09:05:00.00	Ain Deek & Teis Drinking Water Treatment Plant	POST_UV				
185394	WJ026681	29-SEP-2019 09:10:00.00	Ain Deek & Teis Drinking Water Treatment Plant	POST_FILTER				
185395	WJ026681	29-SEP-2019 09:15:00.00	Ain Deek & Teis Drinking Water Treatment Plant	FINALPROD				
185494	WJ026706	1-OCT-2019 09:00:00.00	Ain Deek & Teis Drinking Water Treatment Plant	RW				
185495	WJ026706	1-OCT-2019 09:05:00.00	Ain Deek & Teis Drinking Water Treatment Plant	POST_UV				
185496	WJ026706	1-OCT-2019 09:10:00.00	Ain Deek & Teis Drinking Water Treatment Plant	POST_FILTER				
185497	WJ026706	1-OCT-2019 09:15:00.00	Ain Deek & Teis Drinking Water Treatment Plant	FINALPROD				
155393	WJ021745	2-JAN-2018 09:05:00.00	Ain Deek & Teis Drinking Water Treatment Plant	RW	1.15	35.9		178.9
155394	WJ021745	2-JAN-2018 09:10:00.00	Ain Deek & Teis Drinking Water Treatment Plant	POST_UV	0.9	<1.0		<1.0
155395	WJ021745	2-JAN-2018 09:15:00.00	Ain Deek & Teis Drinking Water Treatment Plant	POST_FILTER	0.82	<1.0		<1.0
155396	WJ021745	2-JAN-2018 09:20:00.00	Ain Deek & Teis Drinking Water Treatment Plant	FINALPROD	0.73	Absence		Absence
155496	WJ021760	4-JAN-2018 09:10:00.00	Ain Deek & Teis Drinking Water Treatment Plant	RW	1.09	8.5		78.9
155497	WJ021760	4-JAN-2018 09:15:00.00	Ain Deek & Teis Drinking Water Treatment Plant	POST_UV	0.91	5.2		83.9
155498	WJ021760	4-JAN-2018 09:20:00.00	Ain Deek & Teis Drinking Water Treatment Plant	POST_FILTER	0.83	13.4		70.3
155499	WJ021760	4-JAN-2018 09:25:00.00	Ain Deek & Teis Drinking Water Treatment Plant	FINALPROD	0.88	Absence		Absence
155590	WJ021770	7-JAN-2018 11:40:00.00	Ain Deek & Teis Drinking Water Treatment Plant	RW	2.32	410.6		>2419.6
155591	WJ021770	7-JAN-2018 11:45:00.00	Ain Deek & Teis Drinking Water Treatment Plant	POST_UV	2.05	<1.0		<1.0
155594	WJ021770	7-JAN-2018 11:55:00.00	Ain Deek & Teis Drinking Water Treatment Plant	POST_FILTER	1.83	2		9.8
155596	WJ021770	7-JAN-2018 12:05:00.00	Ain Deek & Teis Drinking Water Treatment Plant	FINALPROD	1.72	Absence		Absence
155753	WJ021799	9-JAN-2018 08:35:00.00	Ain Deek & Teis Drinking Water Treatment Plant	RW	1.23	71.7		816.4
155754	WJ021799	9-JAN-2018 08:40:00.00	Ain Deek & Teis Drinking Water Treatment Plant	POST_UV	0.92	<1.0		<1.0
155755	WJ021799	9-JAN-2018 08:45:00.00	Ain Deek & Teis Drinking Water Treatment Plant	POST_FILTER	0.84	<1.0		<1.0
155756	WJ021799	9-JAN-2018 08:50:00.00	Ain Deek & Teis Drinking Water Treatment Plant	FINALPROD	0.66	Absence		Absence
155872	WJ021811	11-JAN-2018 07:30:00.00	Ain Deek & Teis Drinking Water Treatment Plant	RW	1.24	24.3		365.4
155873	WJ021811	11-JAN-2018 07:35:00.00	Ain Deek & Teis Drinking Water Treatment Plant	POST_UV	1.12	<1.0		<1.0
155874	WJ021811	11-JAN-2018 07:40:00.00	Ain Deek & Teis Drinking Water Treatment Plant	POST_FILTER	0.88	<1.0		<1.0
155875	WJ021811	11-JAN-2018 07:45:00.00	Ain Deek & Teis Drinking Water Treatment Plant	FINALPROD	0.76	Absence		Absence
155962	WJ021821	14-JAN-2018 11:00:00.00	Ain Deek & Teis Drinking Water Treatment Plant	RW	0.98	6.3		139.6
155963	WJ021821	14-JAN-2018 11:05:00.00	Ain Deek & Teis Drinking Water Treatment Plant	POST_UV	0.81	<1.0		<1.0
155964	WJ021821	14-JAN-2018 11:10:00.00	Ain Deek & Teis Drinking Water Treatment Plant	POST_FILTER	0.75	<1.0		<1.0
155965	WJ021821	14-JAN-2018 11:15:00.00	Ain Deek & Teis Drinking Water Treatment Plant	FINALPROD	0.69	Absence		Absence
156146	WJ021845	16-JAN-2018 09:05:00.00	Ain Deek & Teis Drinking Water Treatment Plant	RW	1.17	108.1		1986.3
156147	WJ021845	16-JAN-2018 09:10:00.00	Ain Deek & Teis Drinking Water Treatment Plant	POST_UV	0.97	<1.0		<1.0
156148	WJ021845	16-JAN-2018 09:15:00.00	Ain Deek & Teis Drinking Water Treatment Plant	POST_FILTER	0.9	<1.0		<1.0
156149	WJ021845	16-JAN-2018 09:20:00.00	Ain Deek & Teis Drinking Water Treatment Plant	FINALPROD	0.85	Absence		Absence
156267	WJ021858	18-JAN-2018 09:00:00.00	Ain Deek & Teis Drinking Water Treatment Plant	RW	0.98	21.8		172.2
156268	WJ021858	18-JAN-2018 09:05:00.00	Ain Deek & Teis Drinking Water Treatment Plant	POST_UV	0.89	<1.0		<1.0
156269	WJ021858	18-JAN-2018 09:10:00.00	Ain Deek & Teis Drinking Water Treatment Plant	POST_FILTER	0.67	<1.0		<1.0
156270	WJ021858	18-JAN-2018 09:15:00.00	Ain Deek & Teis Drinking Water Treatment Plant	FINALPROD	0.6	Absence		Absence
156364	WJ021871	21-JAN-2018 08:40:00.00	Ain Deek & Teis Drinking Water Treatment Plant	RW	1.2	85.5		920.8
156365	WJ021871	21-JAN-2018 08:45:00.00	Ain Deek & Teis Drinking Water Treatment Plant	POST_UV	0.95	<1.0		<1.0
156366	WJ021871	21-JAN-2018 08:50:00.00	Ain Deek & Teis Drinking Water Treatment Plant	POST_FILTER	0.84	<1.0		<1.0
156367	WJ021871	21-JAN-2018 09:00:00.00	Ain Deek & Teis Drinking Water Treatment Plant	FINALPROD	0.71	Absence		Absence
156515	WJ021890	23-JAN-2018 09:30:00.00	Ain Deek & Teis Drinking Water Treatment Plant	RW	1.03	14.6		365.4
156516	WJ021890	23-JAN-2018 09:35:00.00	Ain Deek & Teis Drinking Water Treatment Plant	POST_UV	0.91	<1.0		<1.0

ملحق رقم (١) للعطاء رقم C-T-W-2021-0039

يلغى التصنيف الوارد بدعوه الاعلان رقم (١٠٤) ويعدل كالاتي :
 تعلن شركة مياه اليرموك عن عن طرح العطاء ادناه فعلى الراغبين من ذوي الاختصاص بالاشتراك بهذا العطاء مراجعة مقر الشركة / اربد - شارع بغداد مصطحبين معهم شهادة التصنيف ورخصة مهن سارية المفعول و شهادة غرفة التجارة و السجل التجاري (النسخ الأصلية أو صورة مصدقة) وتفويض للحصول على وثائق دعوة العطاء.
 اعتبارا من صباح يوم الخميس الموافق ٢٠٢١/٨/١٢ وحسب الشروط التالية:-

رقم دعوة العطاء	وصف العمل	كفالة دخول المناقصة	التصنيف	ثمن النسخة غير مسترد (دينار)	آخر موعد لتقديم العروض الساعة الحادي عشر صباح يوم الاثنين
C-T-W-2021-0039	مشروع تأهيل محطة ضخ عين الديك / محافظة جرش	3% من قيمة العرض المقدم	فئة رابعة مياة وصرف صحي فما فوق وفئة محطات تنقية الصرف الصحي ومعالجة مياة الشرب فئة أولى أو ثانية	١٢٥ مائة وخمسة وعشرون دينارا	٢٠٢١ / ٨ / ٢٣

- ✓ آخر موعد لبيع نسخ العطاء الساعة الثالثة والنصف مساء يوم الثلاثاء الموافق ٢٠٢١/٨/١٧ .
- ✓ على المناقص ارفاق ما يثبت تنفيذه مشروع مشابه على الاقل في نفس المجال وان يرفق ما يثبت ذلك ، مع ارفاق حسن الانجاز من صاحب العمل للمشاريع المشابهة .

المهندس منتصر فاضل المومني
 مدير عام شركة مياه اليرموك